


ELSMERE AVENUE
WATER DISTRICT NO. I
TOWN OF BETHLEHEM
RECORD OF INSTALLATION
TOWN OF BETHLEHEM ENGINEERING
DEPARTMENT
SCALE: 1" = 50' NOVEMBER, 1982
DWN. BY: PDH

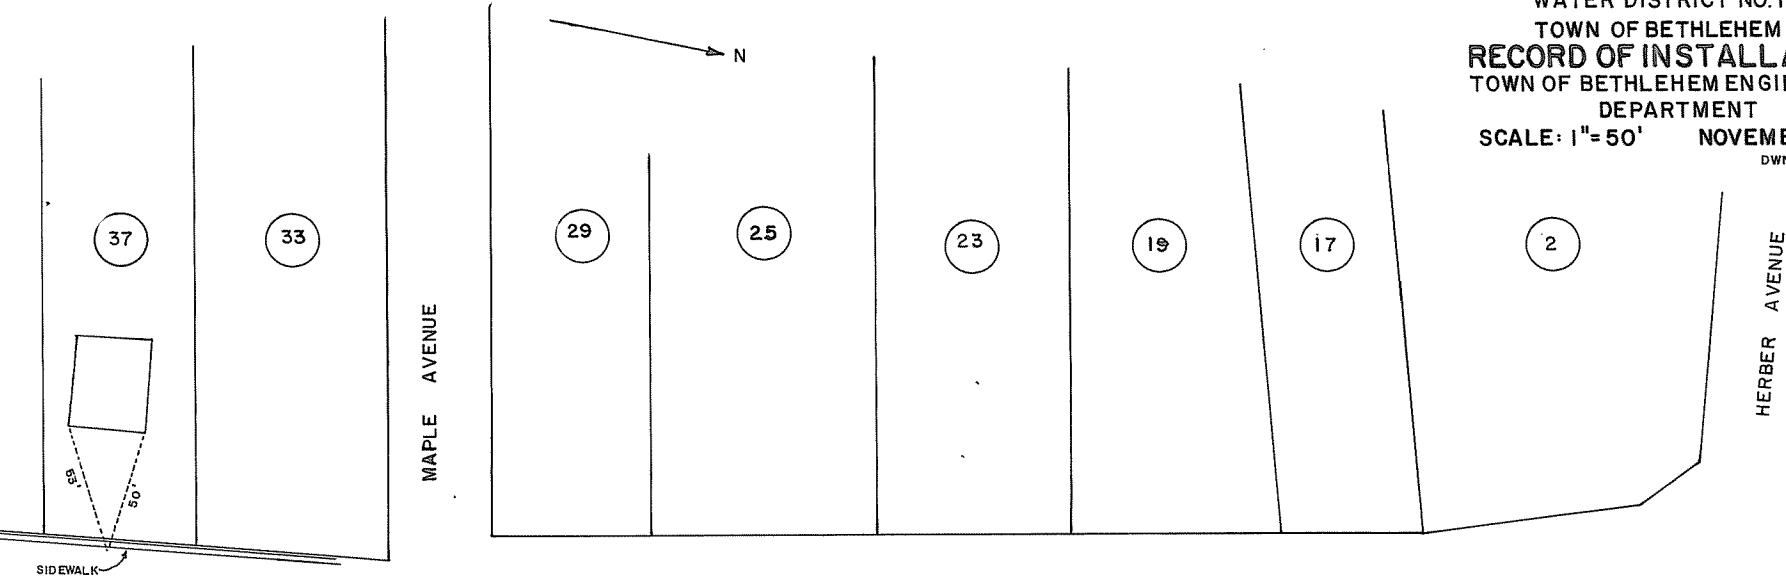

ELSMERE

AVENUE

HERBER AVENUE

36

34

30

14-16

ST. STEPHEN'S CHURCH

POPLAR DRIVE