

ELSMERE AVENUE

WATER DISTRICT NO.1

TOWN OF BETHLEHEM

**RECORD OF INSTALLATION**

TOWN OF BETHLEHEM ENGINEERING

DEPARTMENT

SCALE: 1"=50'


NOVEMBER, 1982

DWN. BY: PDH


BETHLEHEM CEMETARY ASSOCIATION, INC.

ELSMERE

KENWOOD

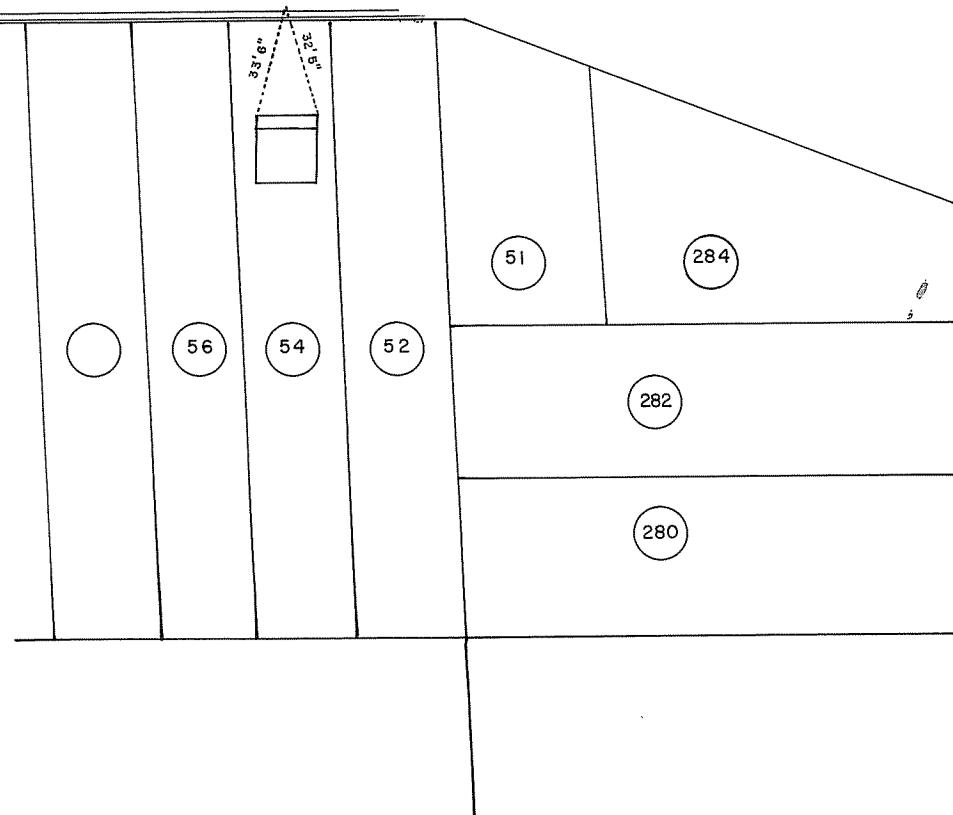

AVENUE

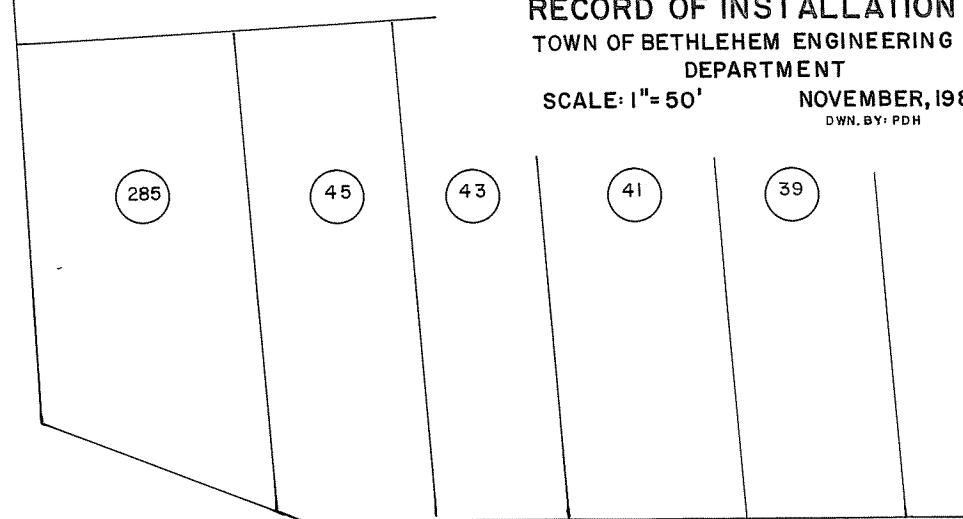

AVENUE

