

ELSMERE AVENUE

WATER DISTRICT NO.1

TOWN OF BETHLEHEM

RECORD OF INSTALLATION

TOWN OF BETHLEHEM ENGINEERING

DEPARTMENT

SCALE: 1"=50' NOVEMBER, 1982

DWN. BY: PDH

N

95


91

87

85


83

81

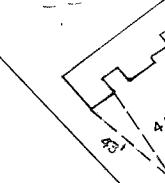

ELSMERE

AVENUE

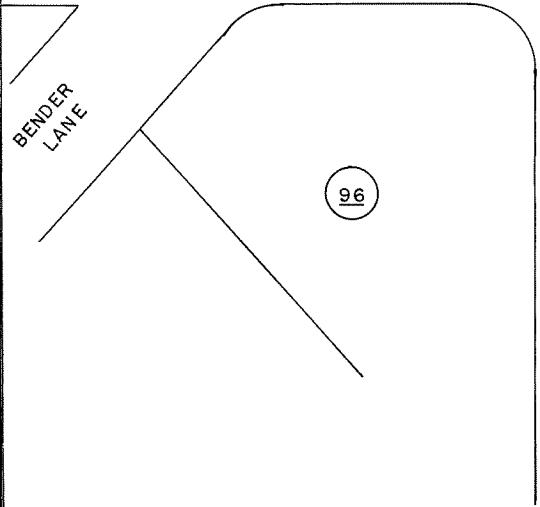

96

