


ELSMERE AVENUE
WATER DISTRICT NO. 1
TOWN OF BETHLEHEM
RECORD OF INSTALLATION
TOWN OF BETHLEHEM ENGINEERING
DEPARTMENT
SCALE: 1"=50' NOVEMBER, 1982
DWN. BY: PDH



ELSMERE

AVENUE

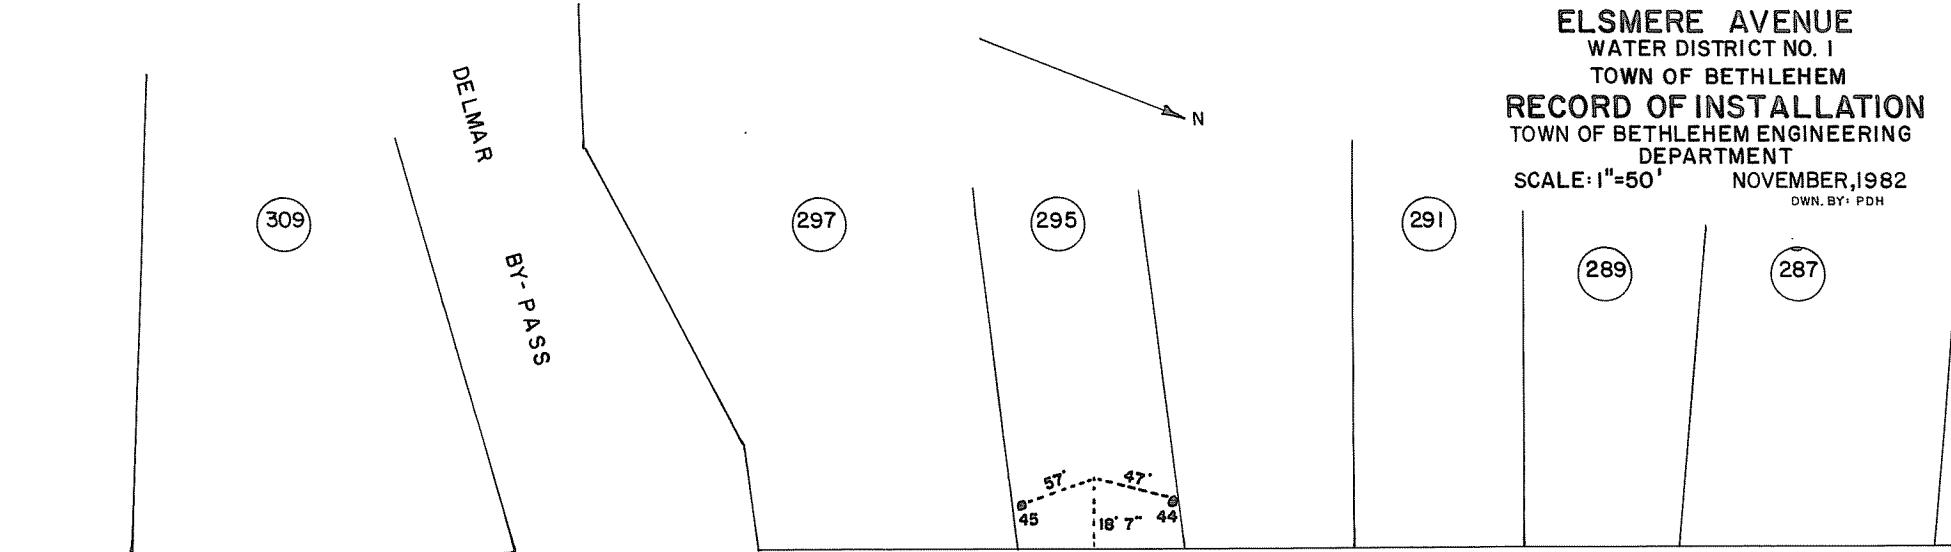