

ELSMERE AVENUE

WATER DISTRICT NO. I

TOWN OF BETHLEHEM

**RECORD OF INSTALLATION**

TOWN OF BETHLEHEM ENGINEERING


DEPARTMENT

SCALE: 1"=50'

NOVEMBER, 1982

DWN. BY: PDH

→ N

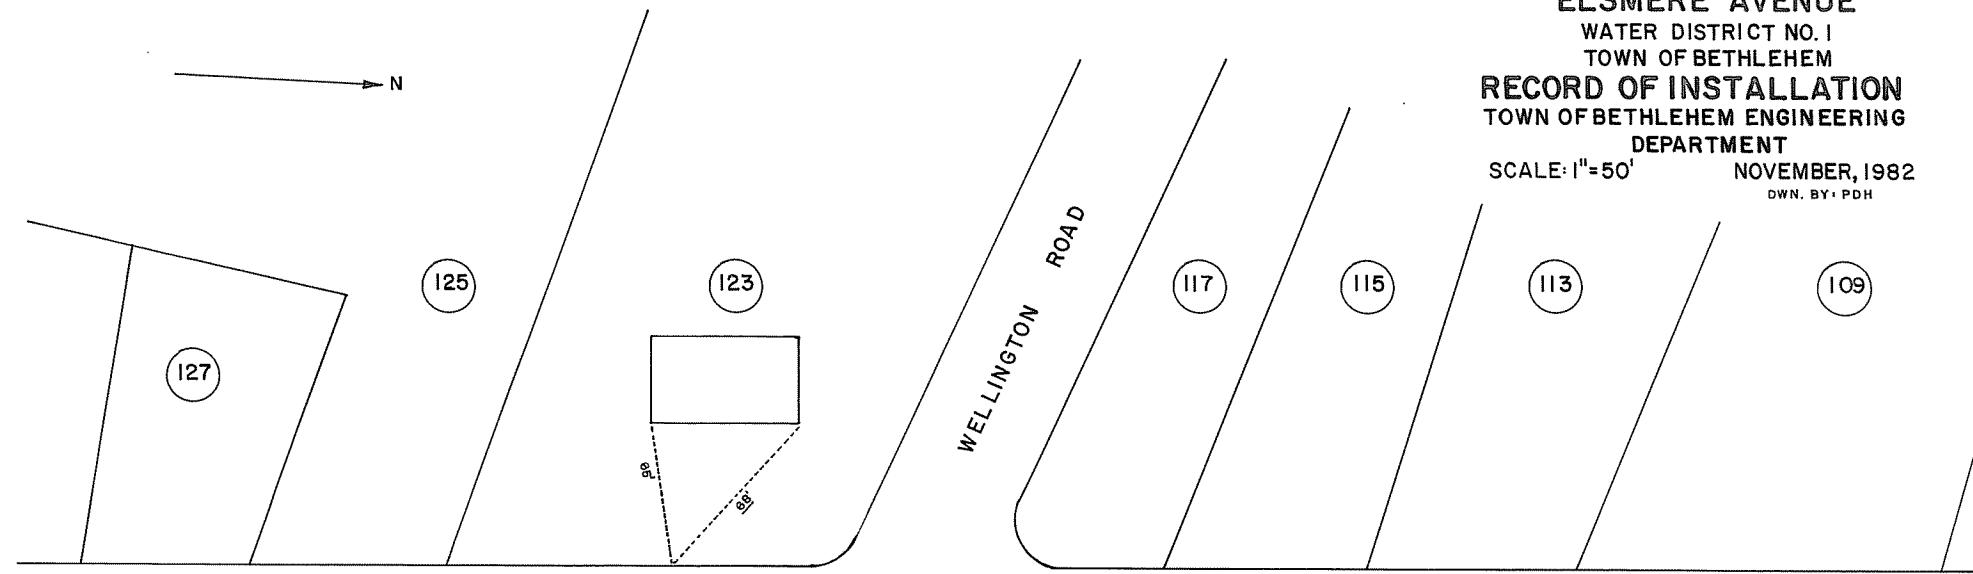

ELSMERE

AVENUE

