


NOT TO SCALE

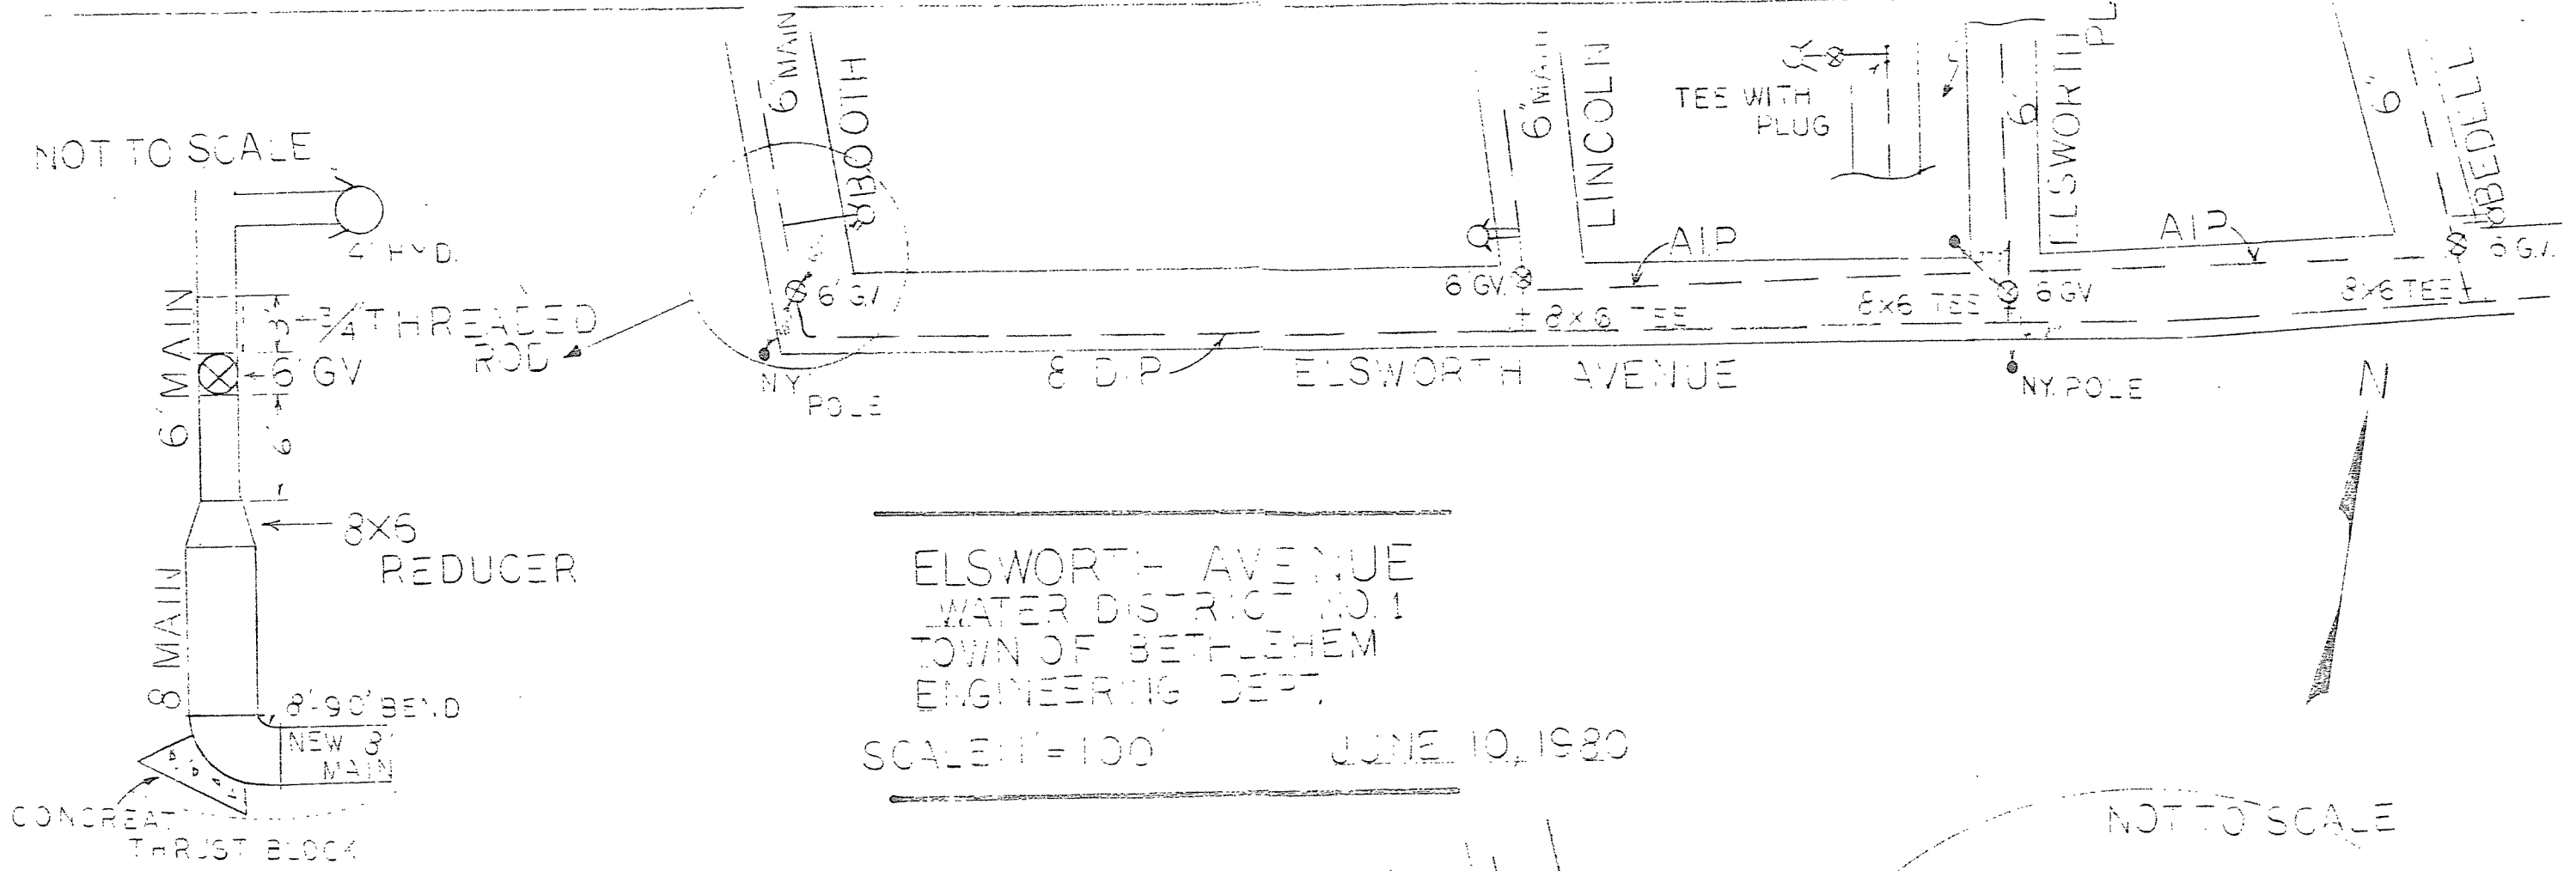

ELSWORTH AVENUE
WATER DISTRICT NO. 1
TOWN OF BETHLEHEM
ENGINEERING DEPT.

SCALE 1" = 100'

JUNE 10, 1980

