




NOT TO SCALE

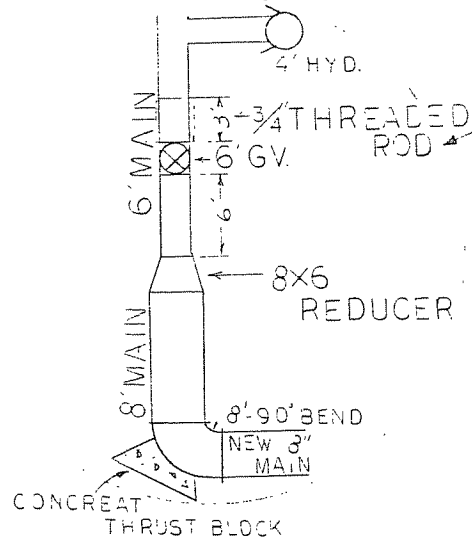

ELSWORTH AVENUE
WATER DISTRICT NO 1
TOWN OF BETHLEHEM
ENGINEERING DEPT.

SCALE: 1" = 100'

JUNE 10, 1980

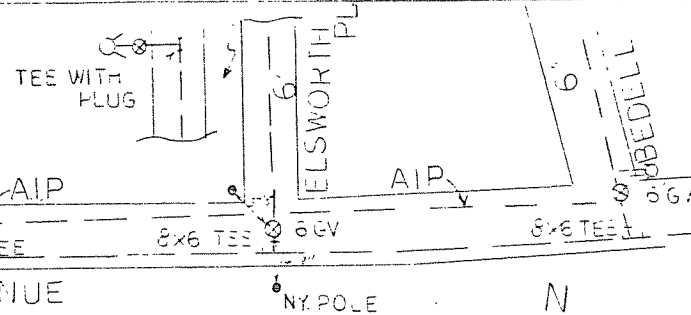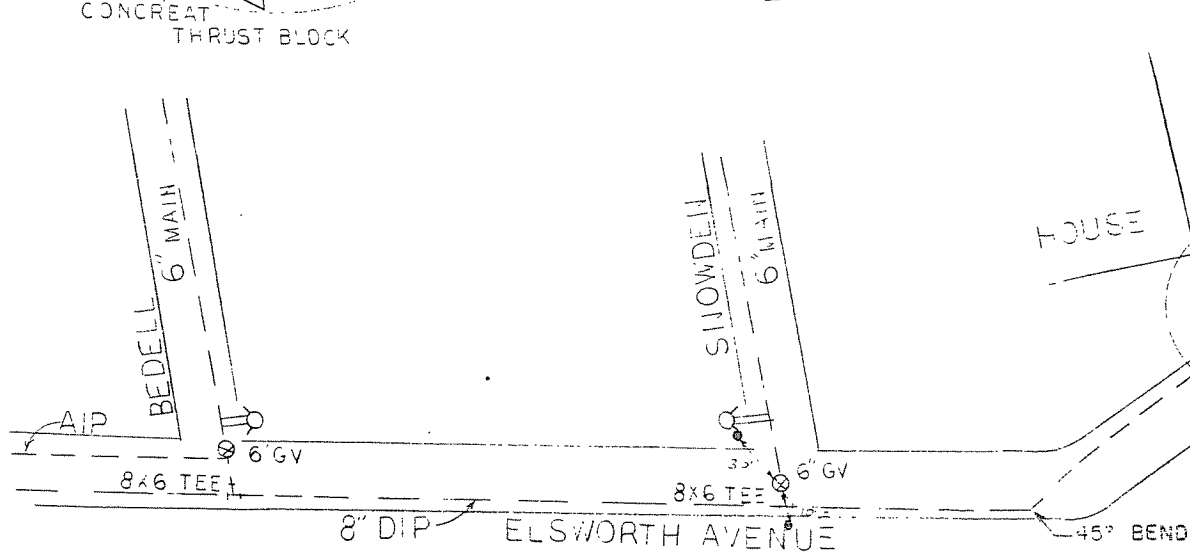

NOT TO SCALE

