



ELWOOD ROAD
WATER DISTRICT NO. I
TOWN OF BETHLEHEM

RECORD OF INSTALLATION
TOWN OF BETHLEHEM ENGINEERING
DEPARTMENT
SCALE: 1" = 50' JANUARY, 1982
DWN. BY: PDH

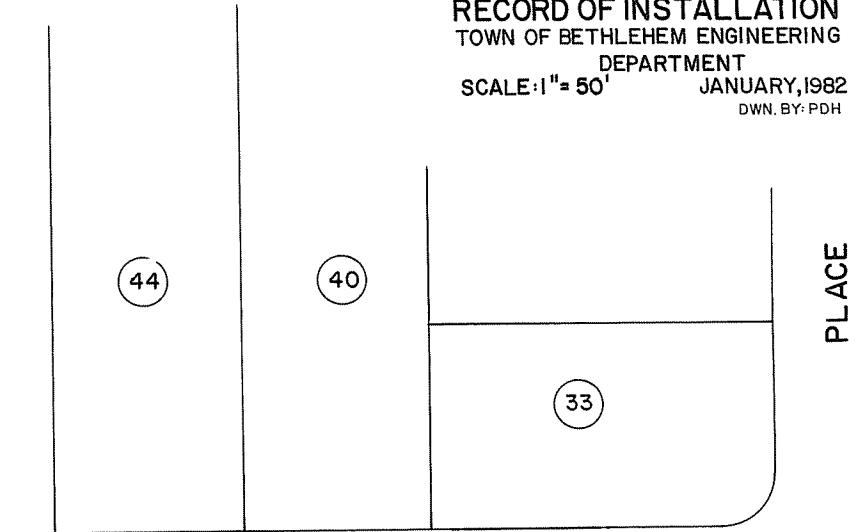

ELWOOD ROAD

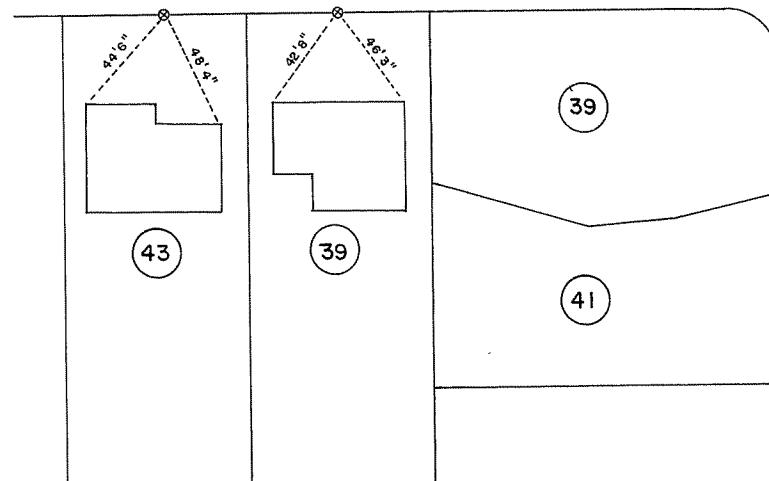

PLACE

FREDRICK