


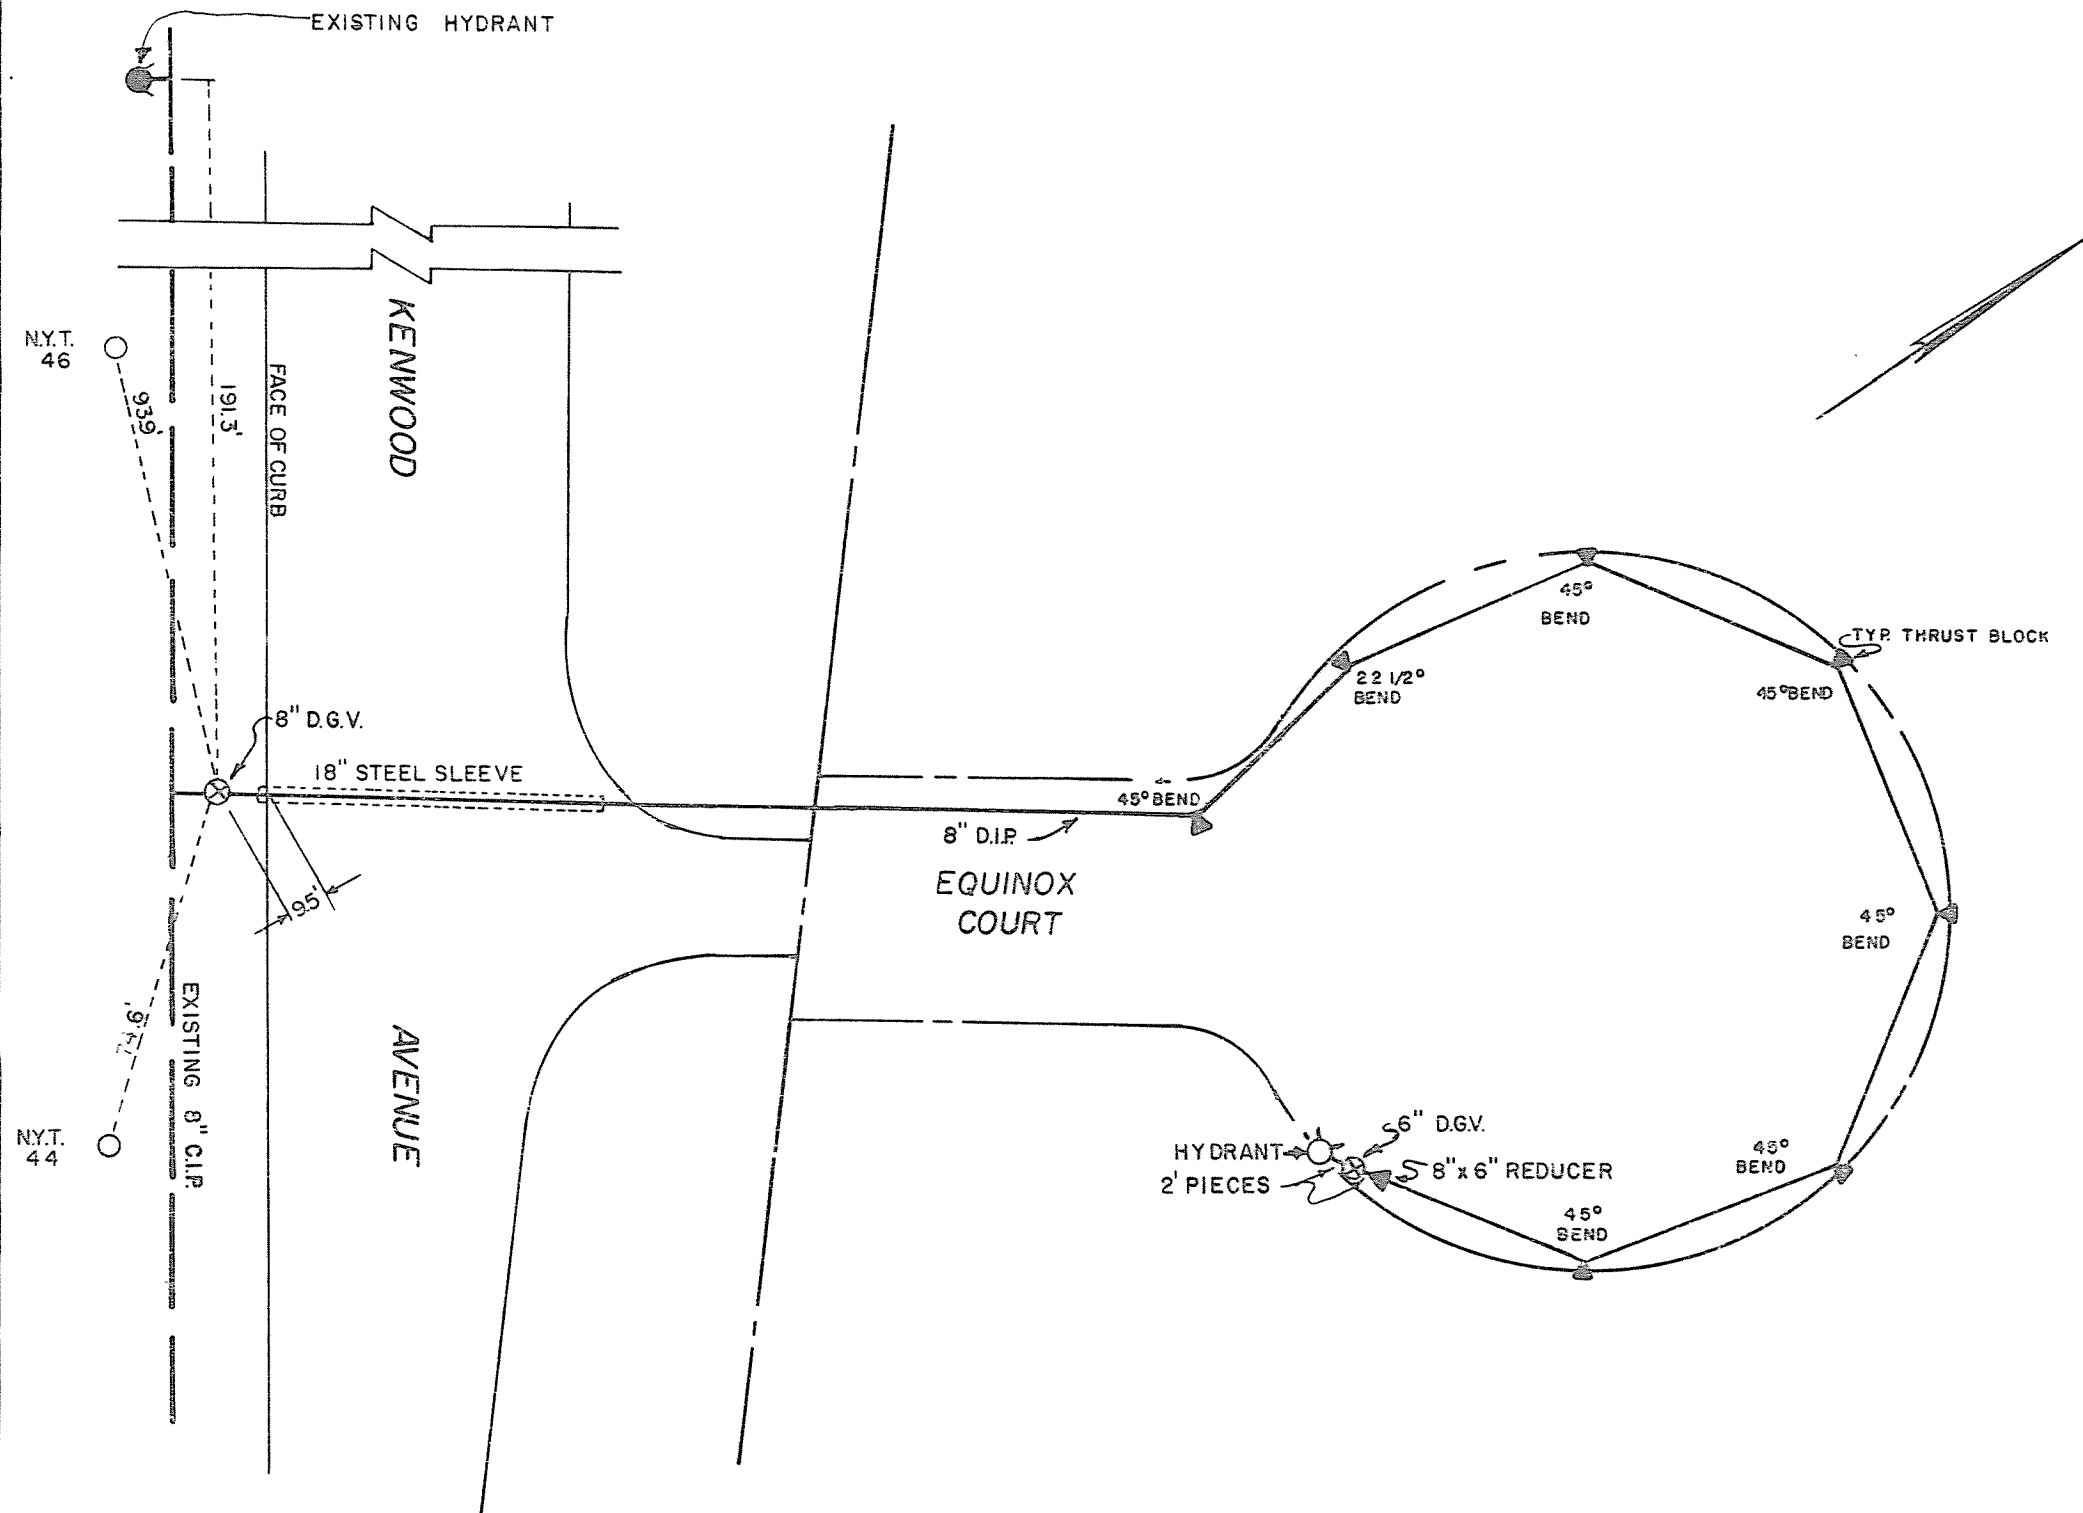

CONSTRUCTED BY TOWN FORCES IN SPRING OF 1978

SOIL - YELLOW SAND

DWN. BY- GLM.
CKD. BY - W.T.B.

EQUINOX COURT
WATER DISTRICT No. 1
TOWN OF BETHLEHEM
RECORD OF INSTALLATION
 SCALE: 1" = 40' MAY 1978
 J. KENNETH FRASER & ASSOCIATES, P. C.
 CONSULTING ENGINEERS RENSSELAER, N. Y.