


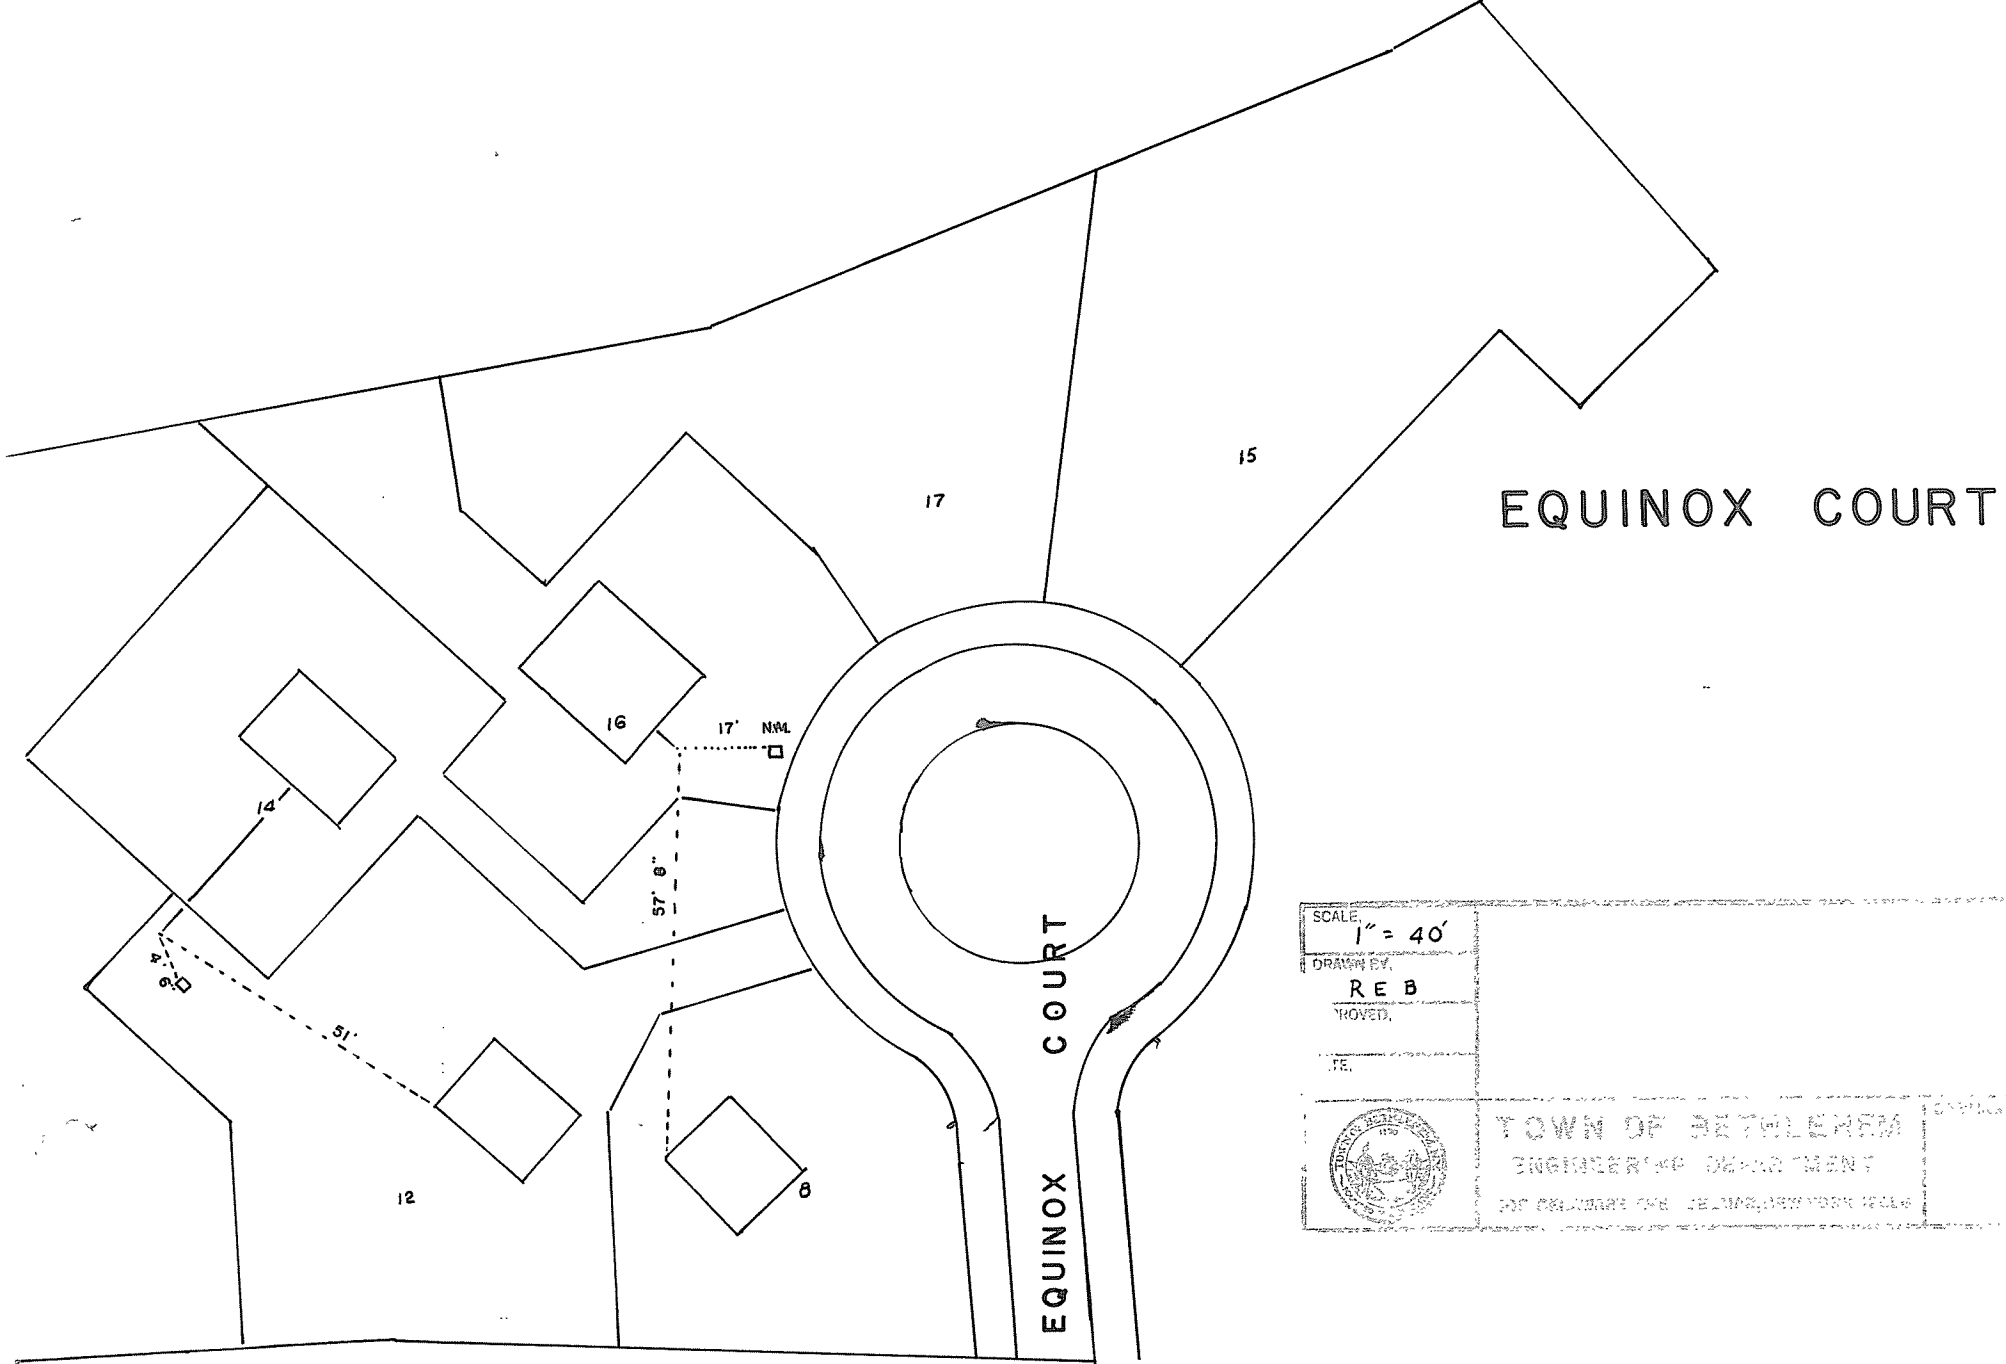

EQUINOX COURT

EQUINOX COURT

SCALE: 1" = 40'		TOWN OF BRENTWOOD
DRAWN BY: RE B		ENGINEERING DEPARTMENT
APPROVED:		OF PLANNING AND DEVELOPMENT
DATE:		