


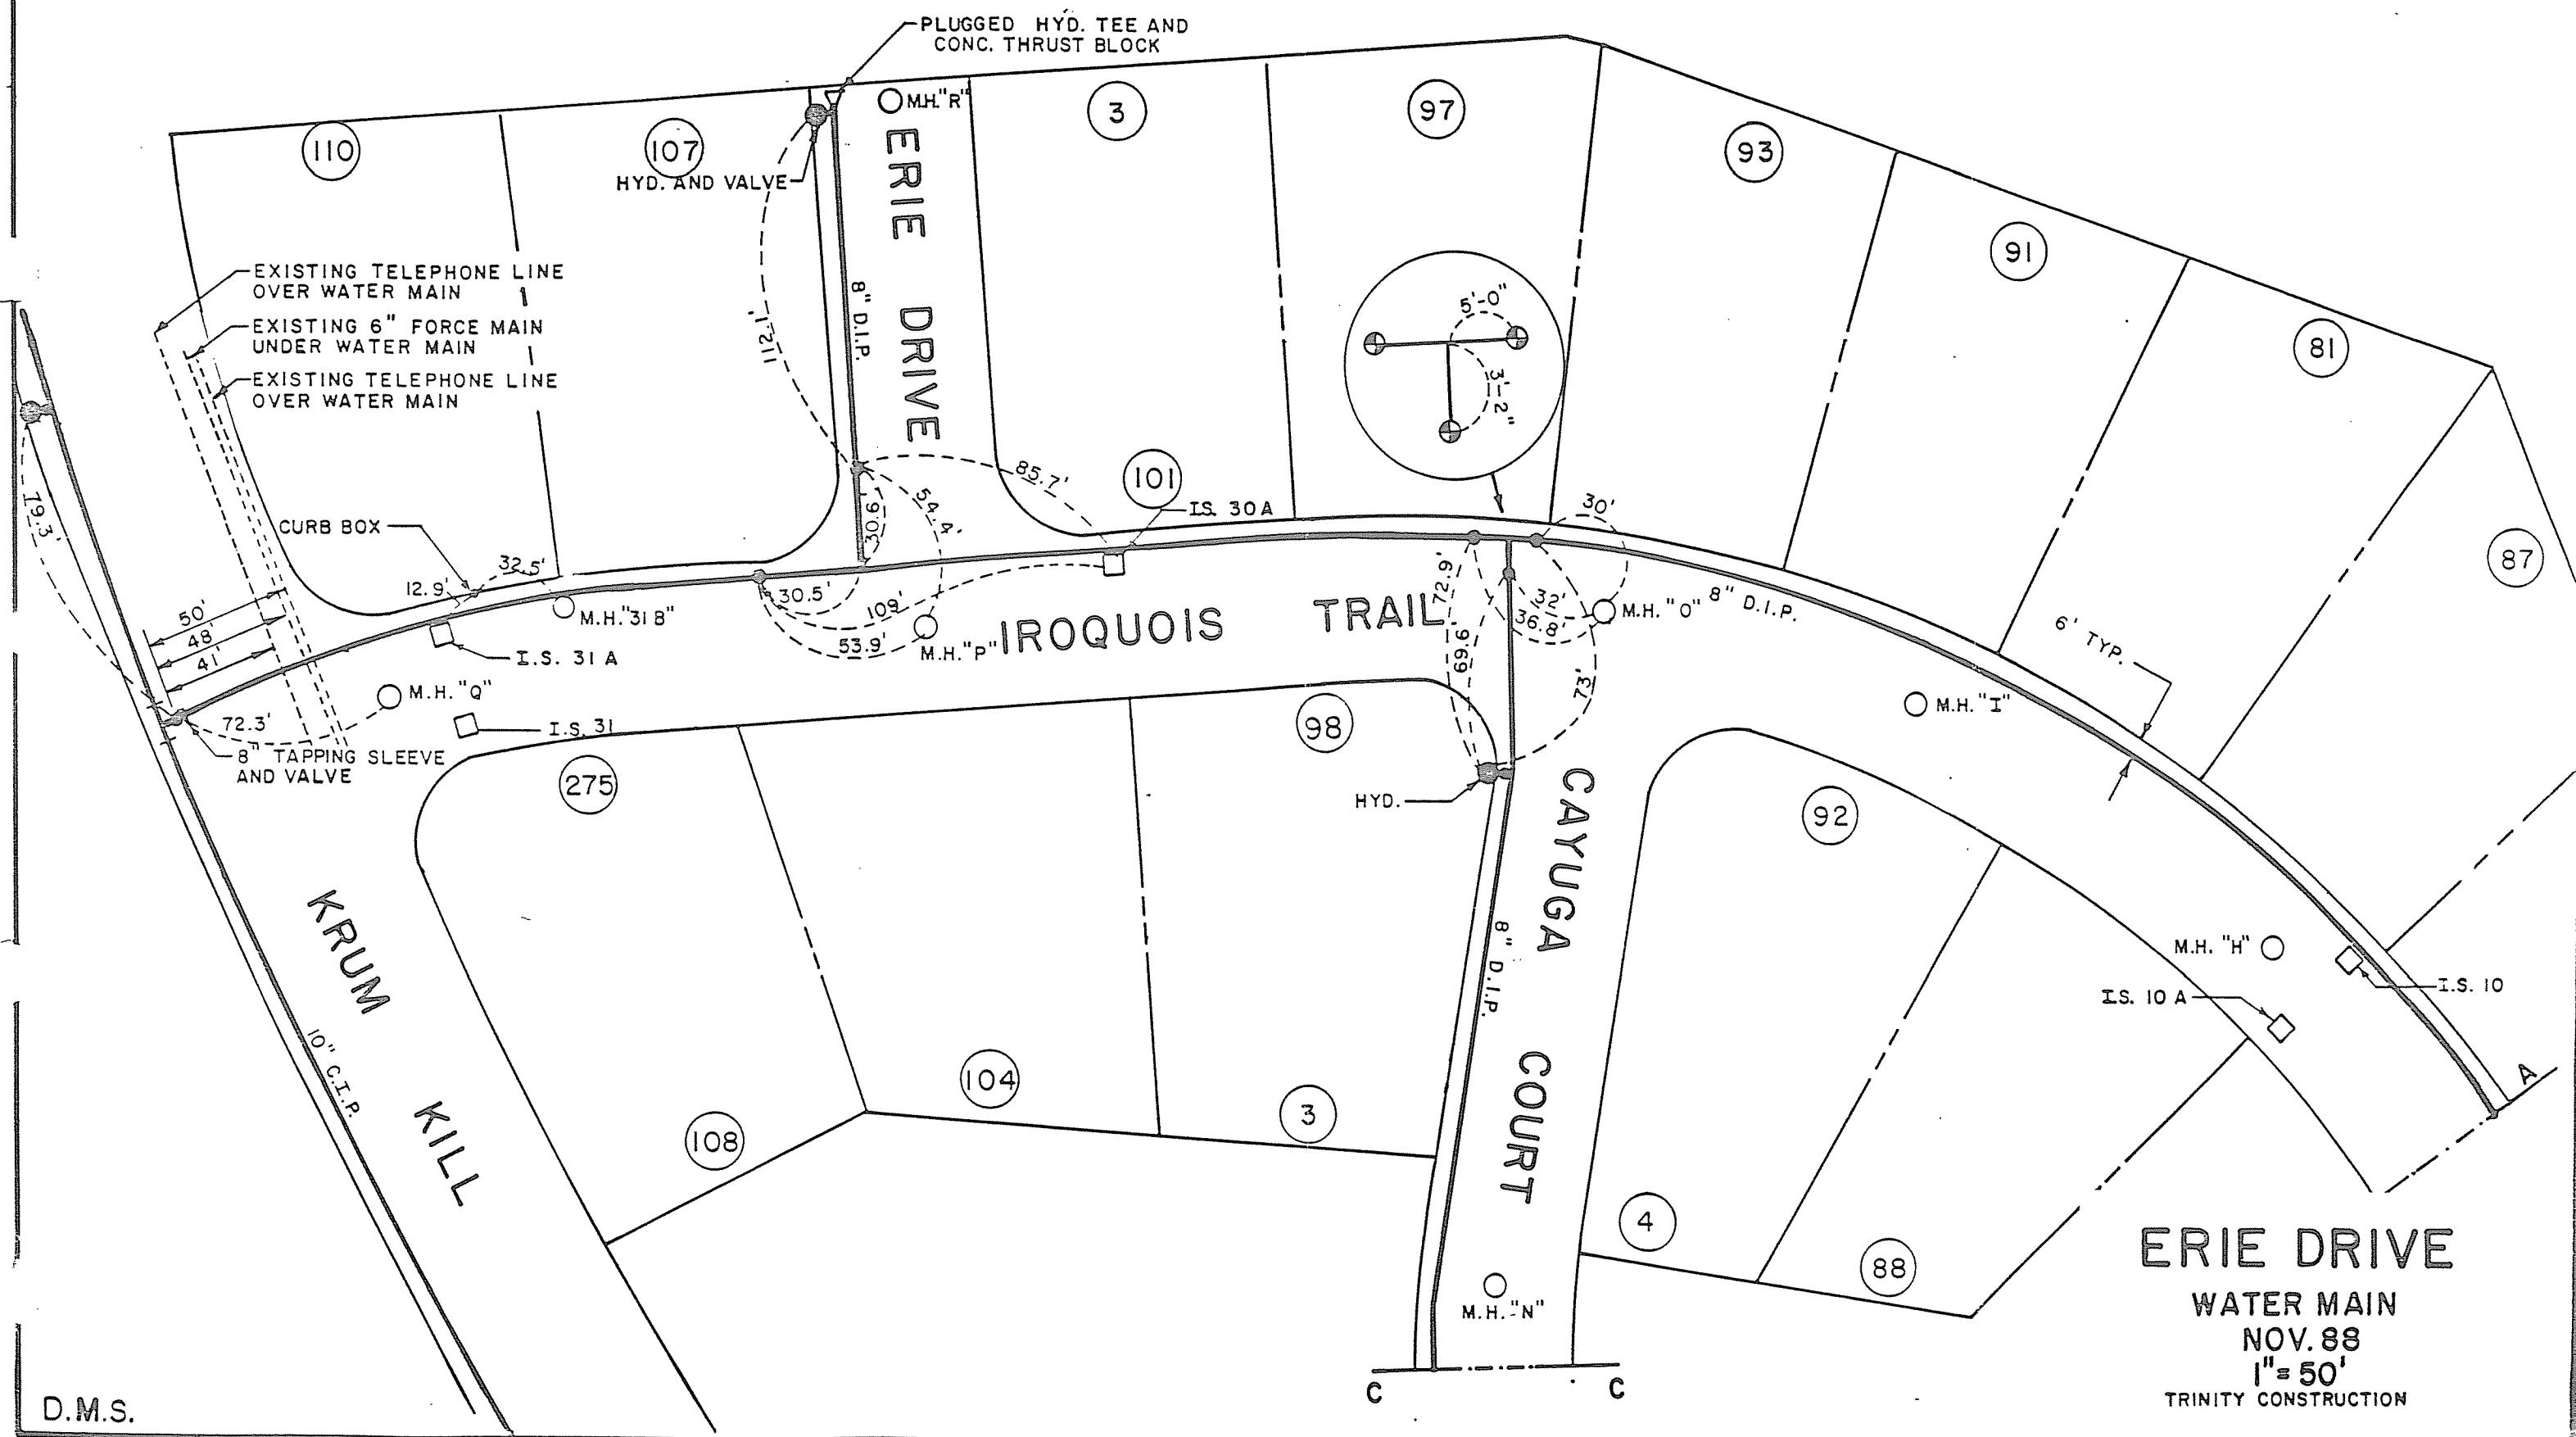

D.M.S.

ERIE DRIVE

WATER MAIN

NOV. 88

1" = 50'

TRINITY CONSTRUCTION