


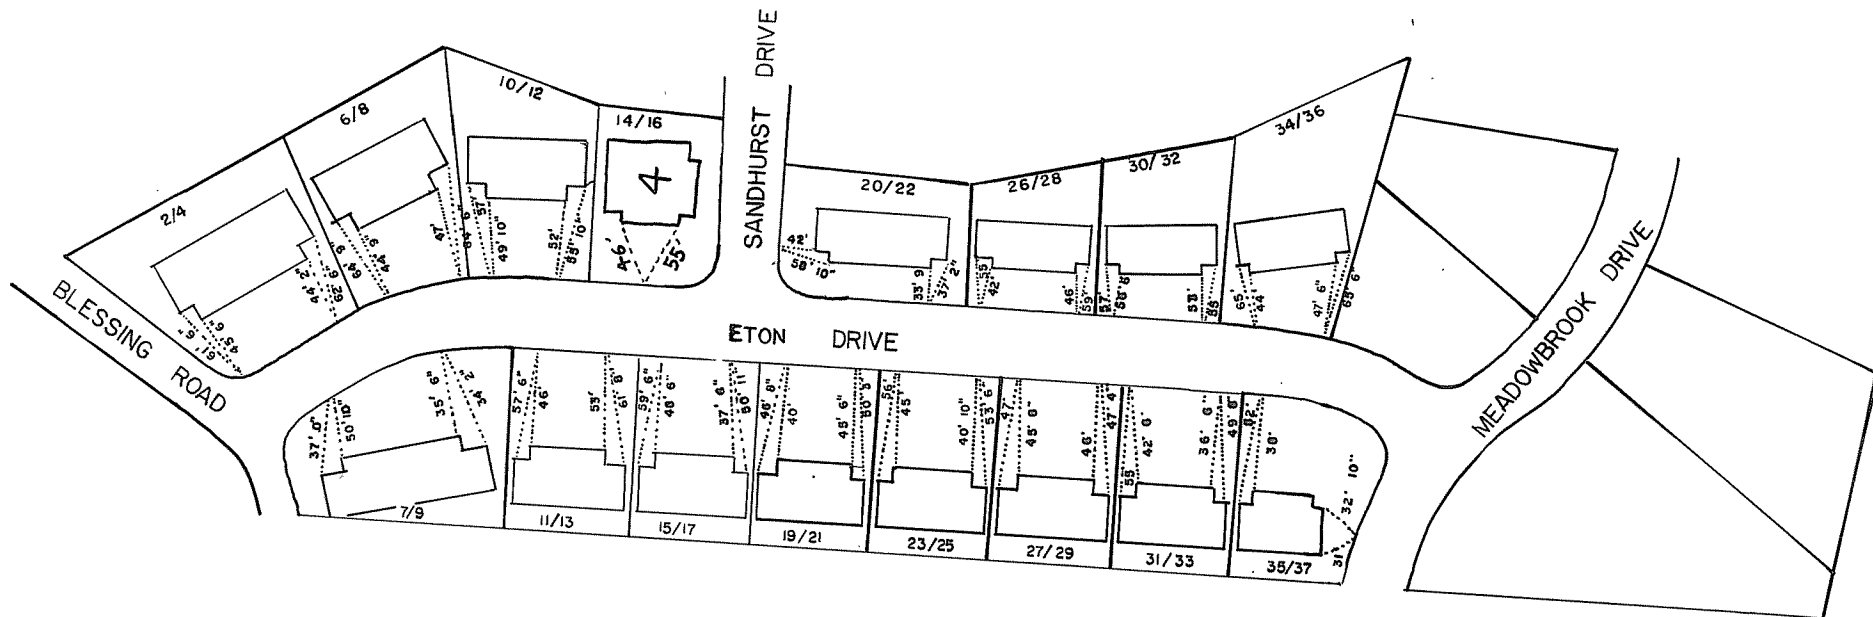

ETON DRIVE