


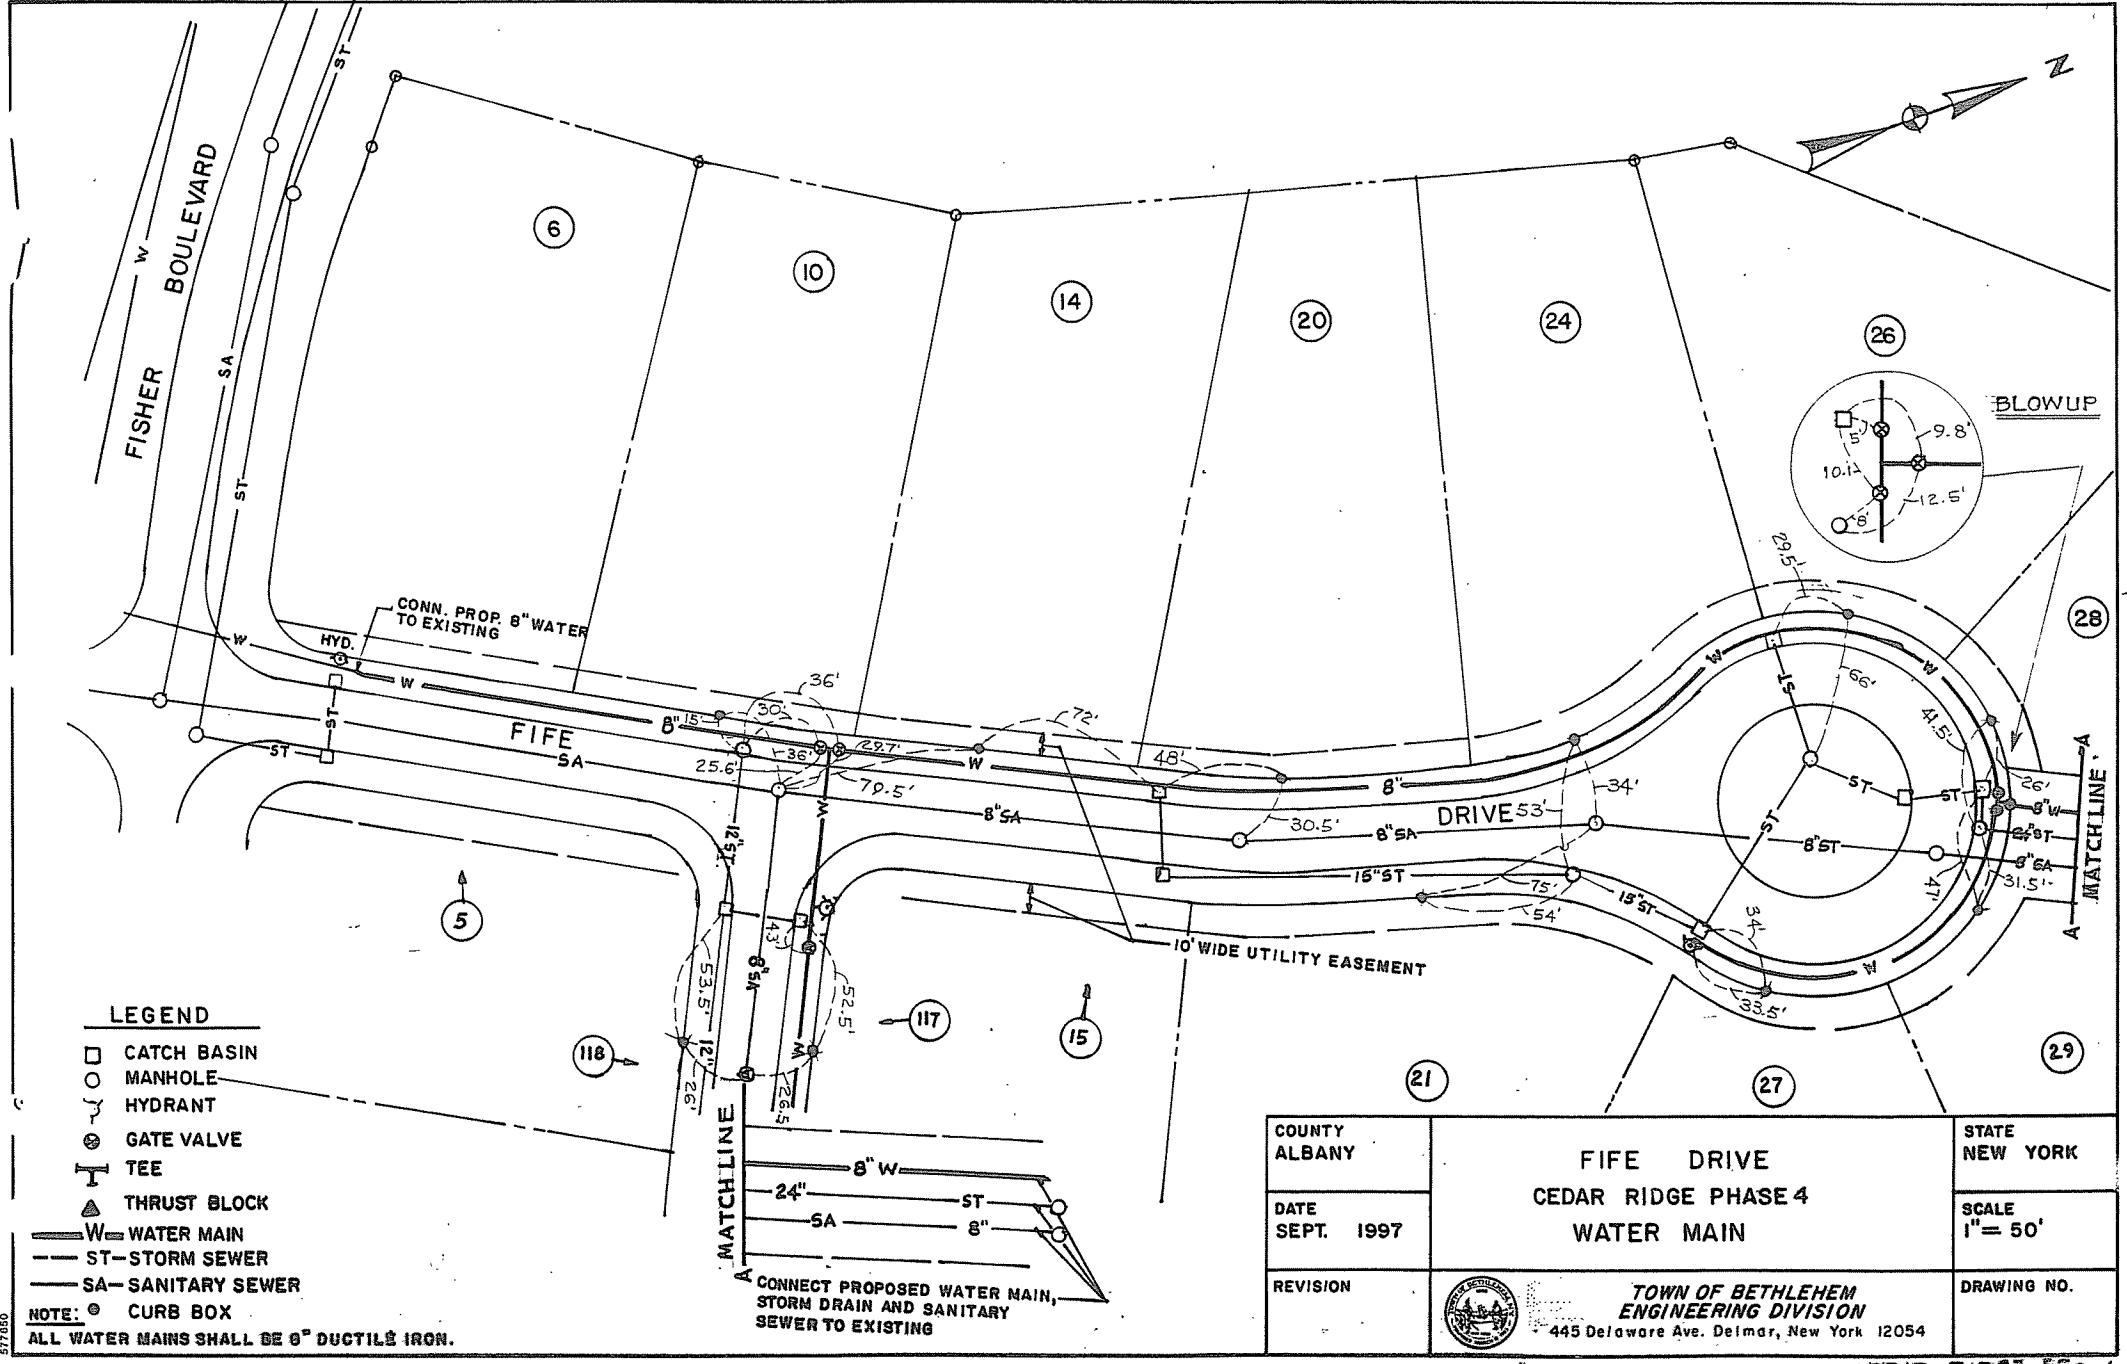

COUNTY ALBANY	FIFE DRIVE CEDAR RIDGE PHASE 4 WATER MAIN	STATE NEW YORK
DATE SEPT. 1997		SCALE 1" = 50'
REVISION	 TOWN OF BETHLEHEM ENGINEERING DIVISION 445 Delaware Ave. Delmar, New York 12054	DRAWING NO.