
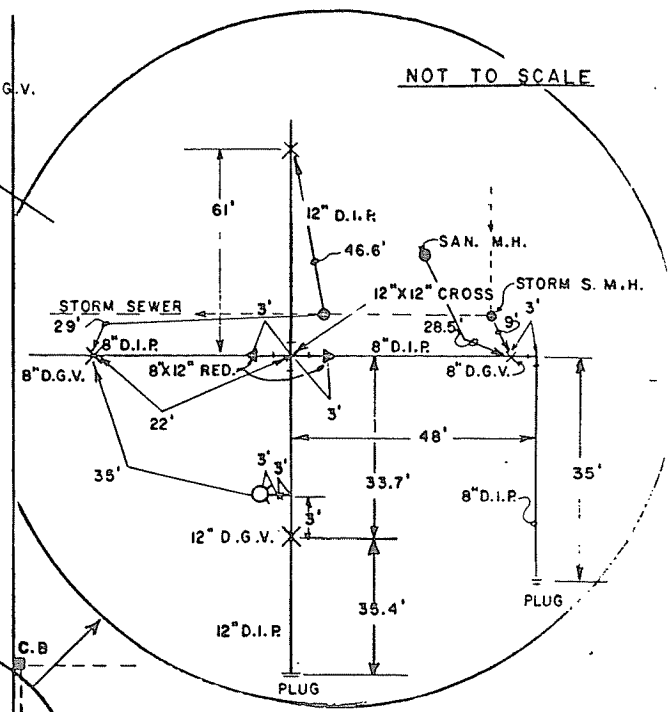


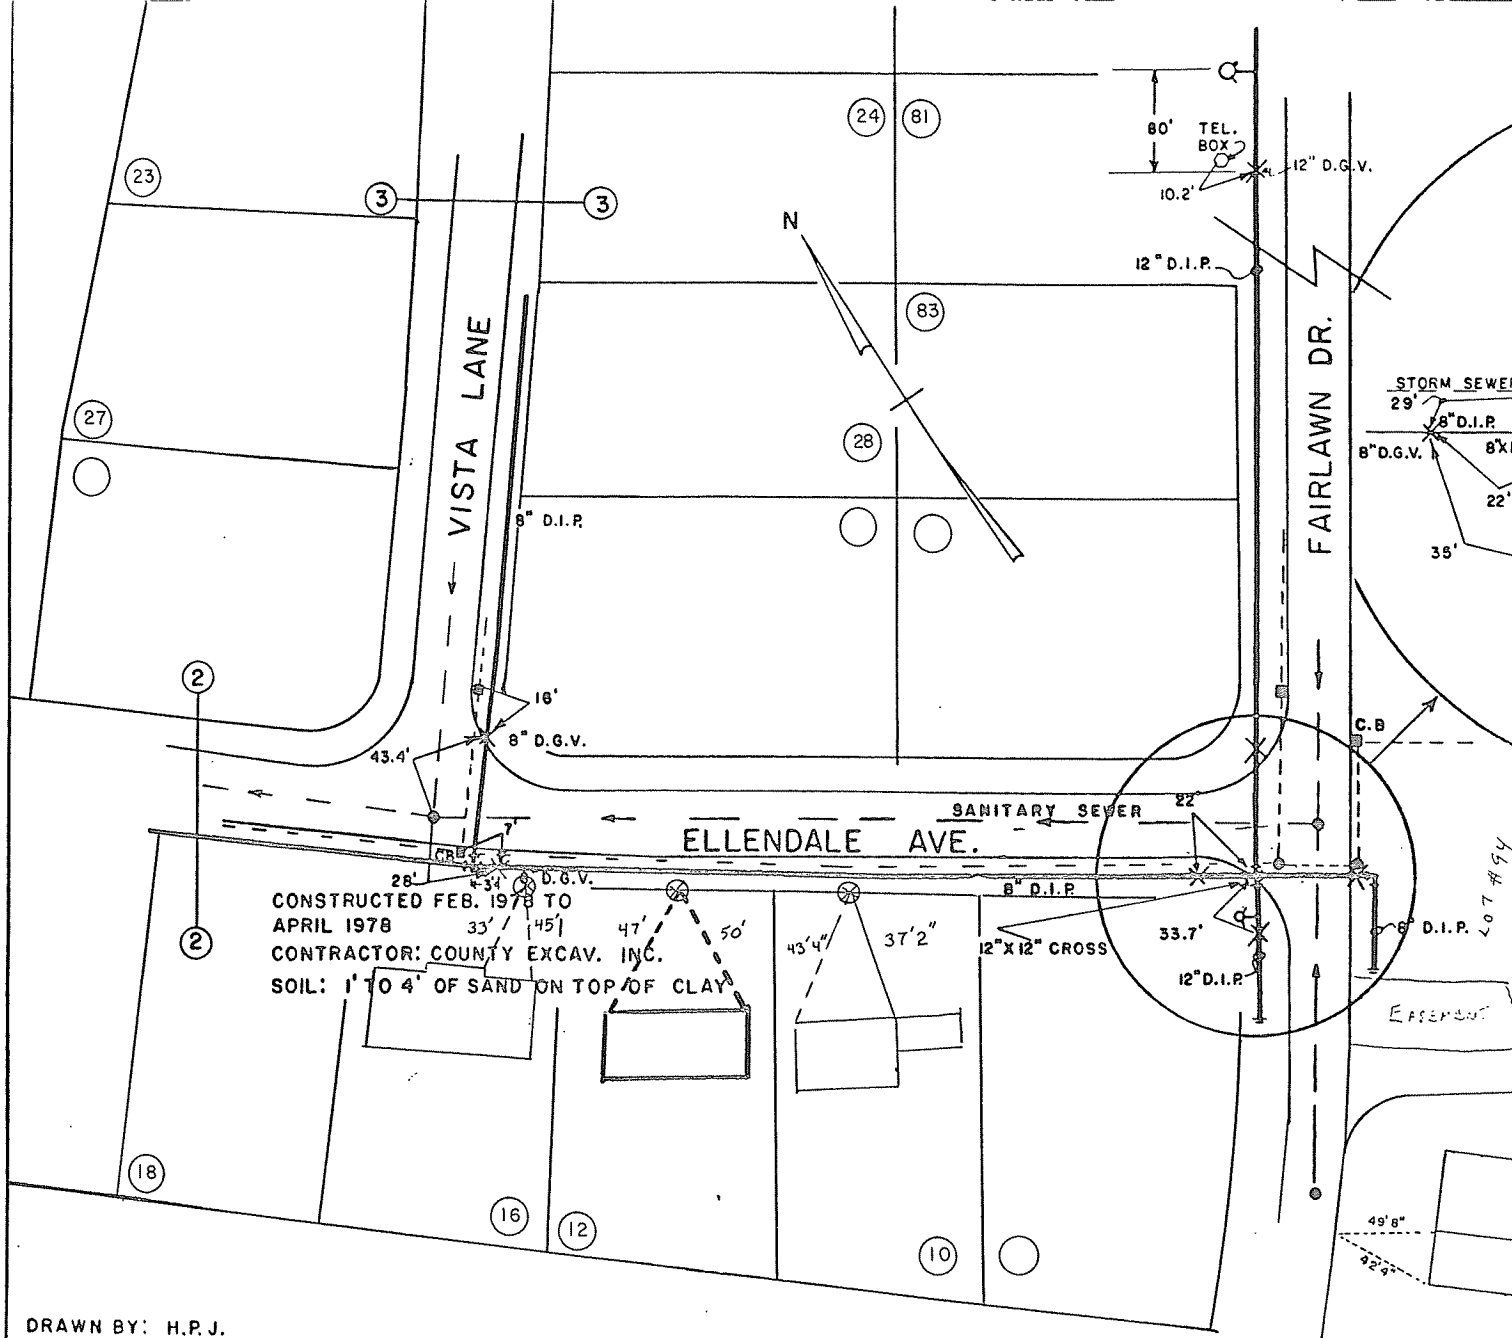

DRAWN BY: H.P.J.
 CHECKED BY: W.T.B.

FAIRLAWN DR.
 SKYCREST
 WATER DISTRICT NO. 1
 TOWN OF BETHLEHEM
 RECORD OF INSTALLATION
 SCALE: 1" = 50' APRIL 1978
 J. KENNETH FRASER & ASSOCIATES, P.C.
 CONSULTING ENGINEERS RENSSELAER, N.Y.

VISTA LANE