


FAIRLAWN

DRIVE

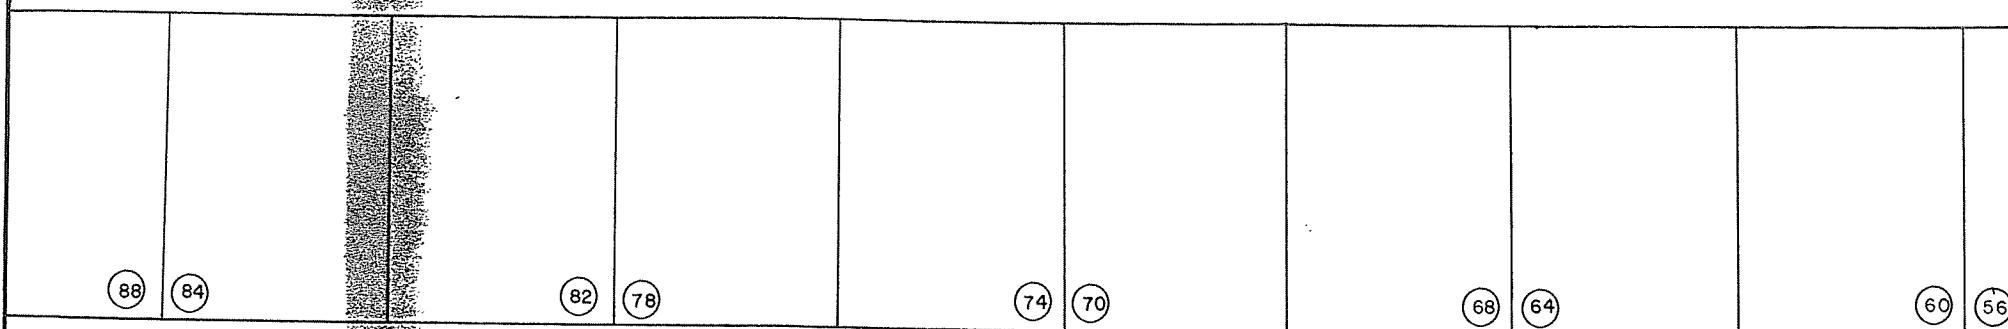

SEE ALLENDALE

FAIRLAWN DRIVE  
SKYCREST  
RECORD OF INSTALLATION  
WATER DISTRICT NO.1  
TOWN OF BETHLEHEM  
SCALE 1"=50' FEB. 1981  
TOWN OF BETHLEHEM ENGINEERING  
DEPARTMENT  
DWN BY C.W.