


- LEGEND**
- CATCH BASIN
 - MANHOLE
 - ⊙ HYDRANT
 - GATE VALVE
 - ⊥ TEE
 - ▲ THRUST BLOCK
 - W— WATER MAIN

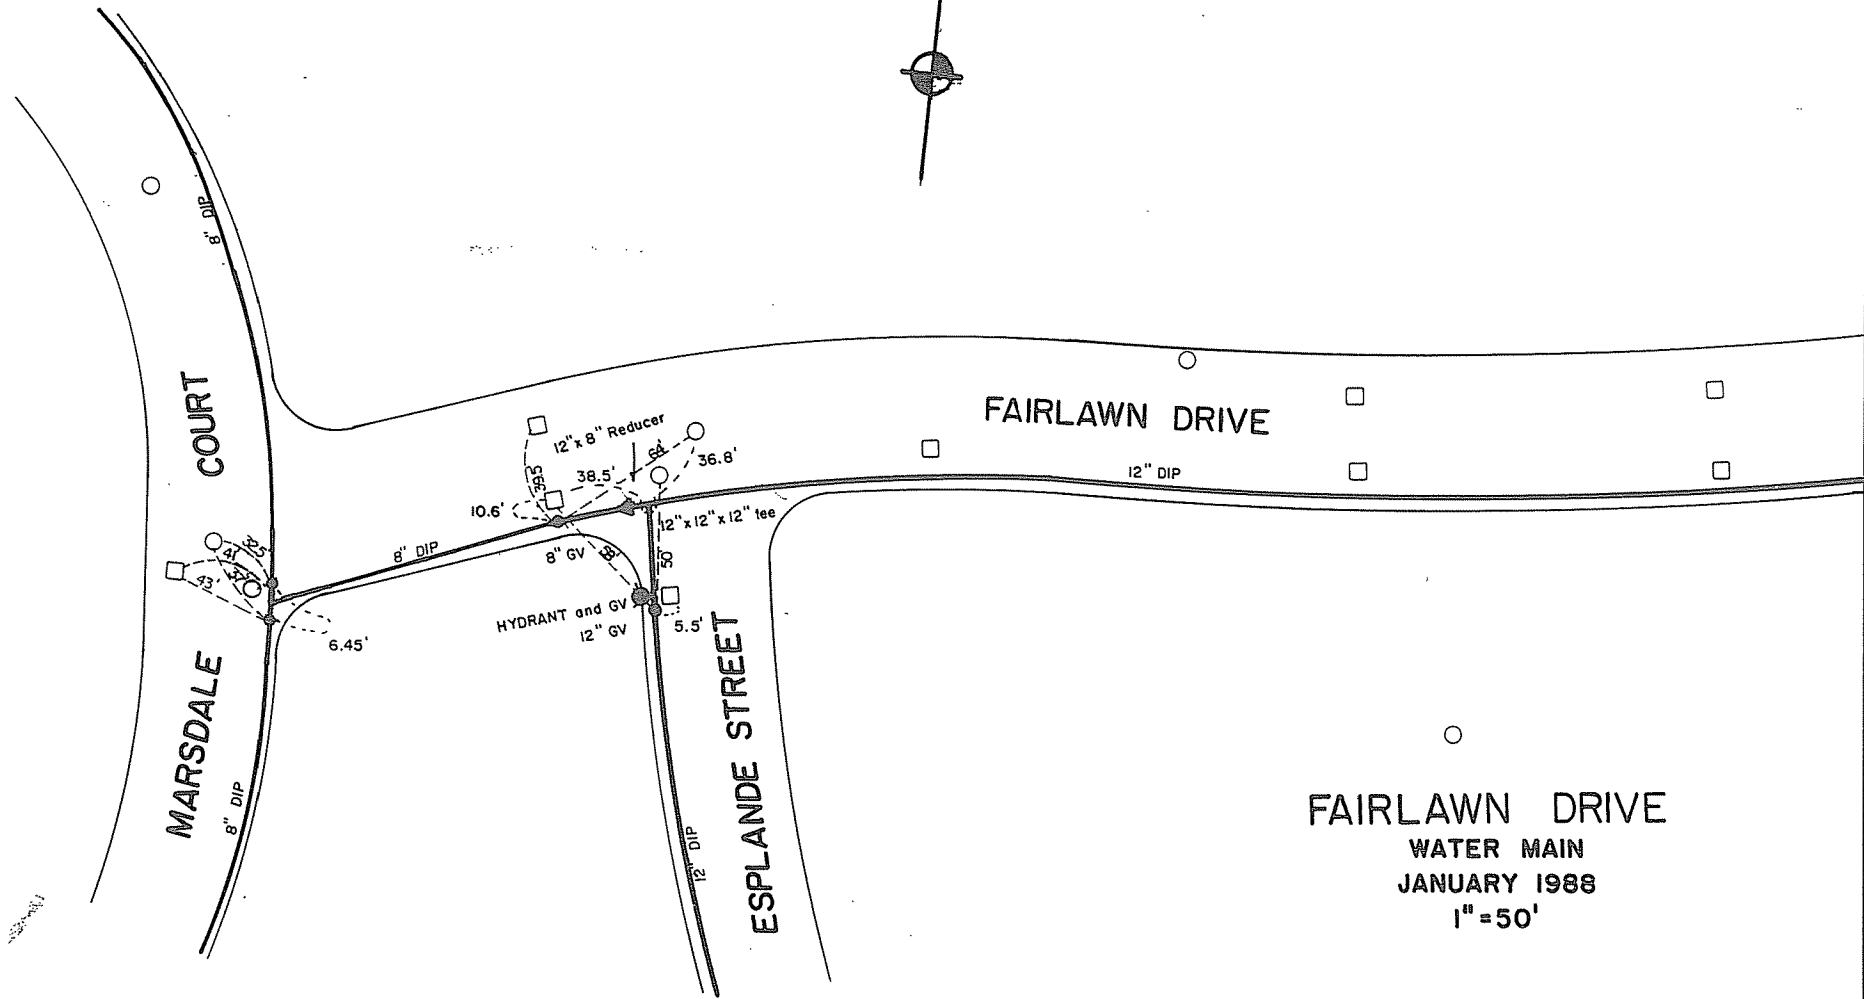

FAIRLAWN DRIVE
 WATER MAIN
 JANUARY 1988
 1" = 50'