


FAIRLAWN

DRIVE

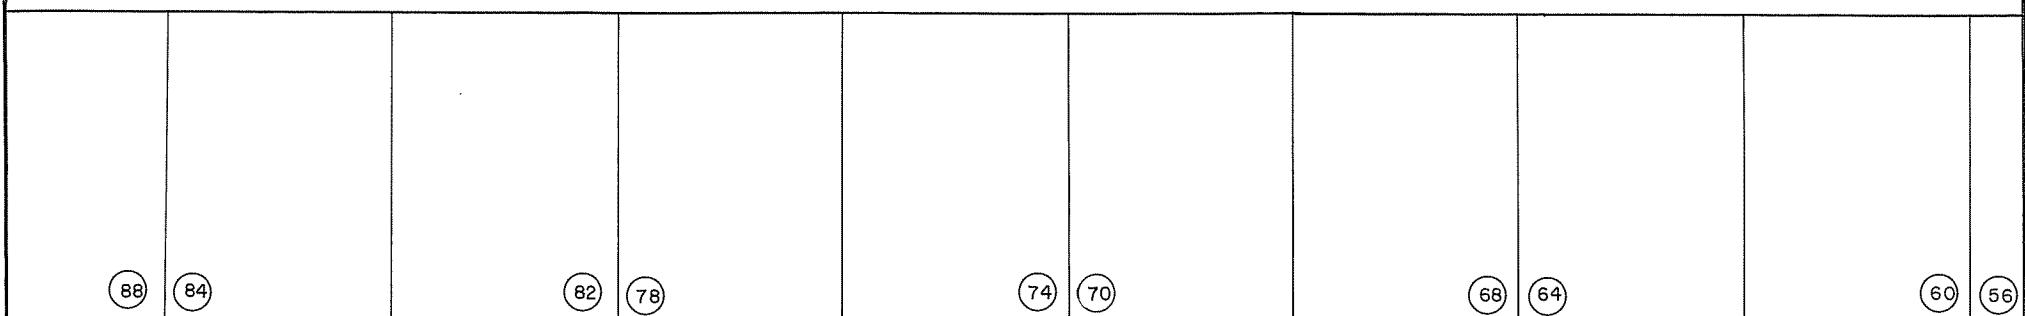

FAIRLAWN DRIVE
SKYCREST
RECORD OF INSTALLATION
WATER DISTRICT NO. I
TOWN OF BETHLEHEM
SCALE 1"=50' FEB. 1981
TOWN OF BETHLEHEM ENGINEERING
DEPARTMENT
DWN BY C.W.