


TWIN 96"
CULVERT
PIPES

TO ESPLANDE

FAIRLAWN DRIVE

12" DIP

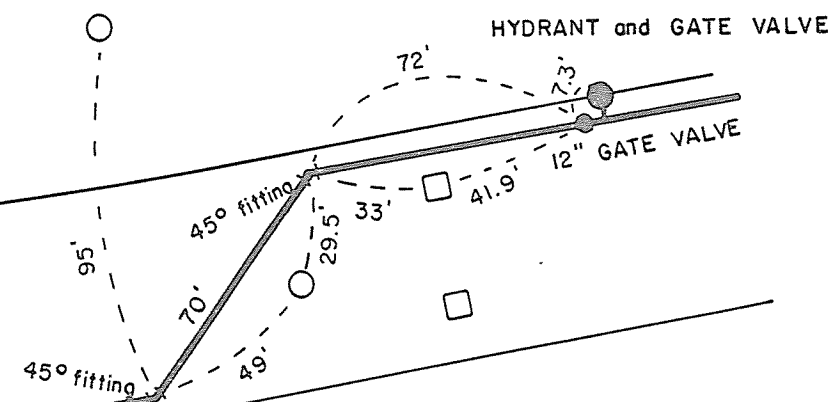

HYDRANT and GATE VALVE

12" GATE VALVE

FAIRLAWN DRIVE
WATER MAIN
JANUARY 1988
1" = 50'