



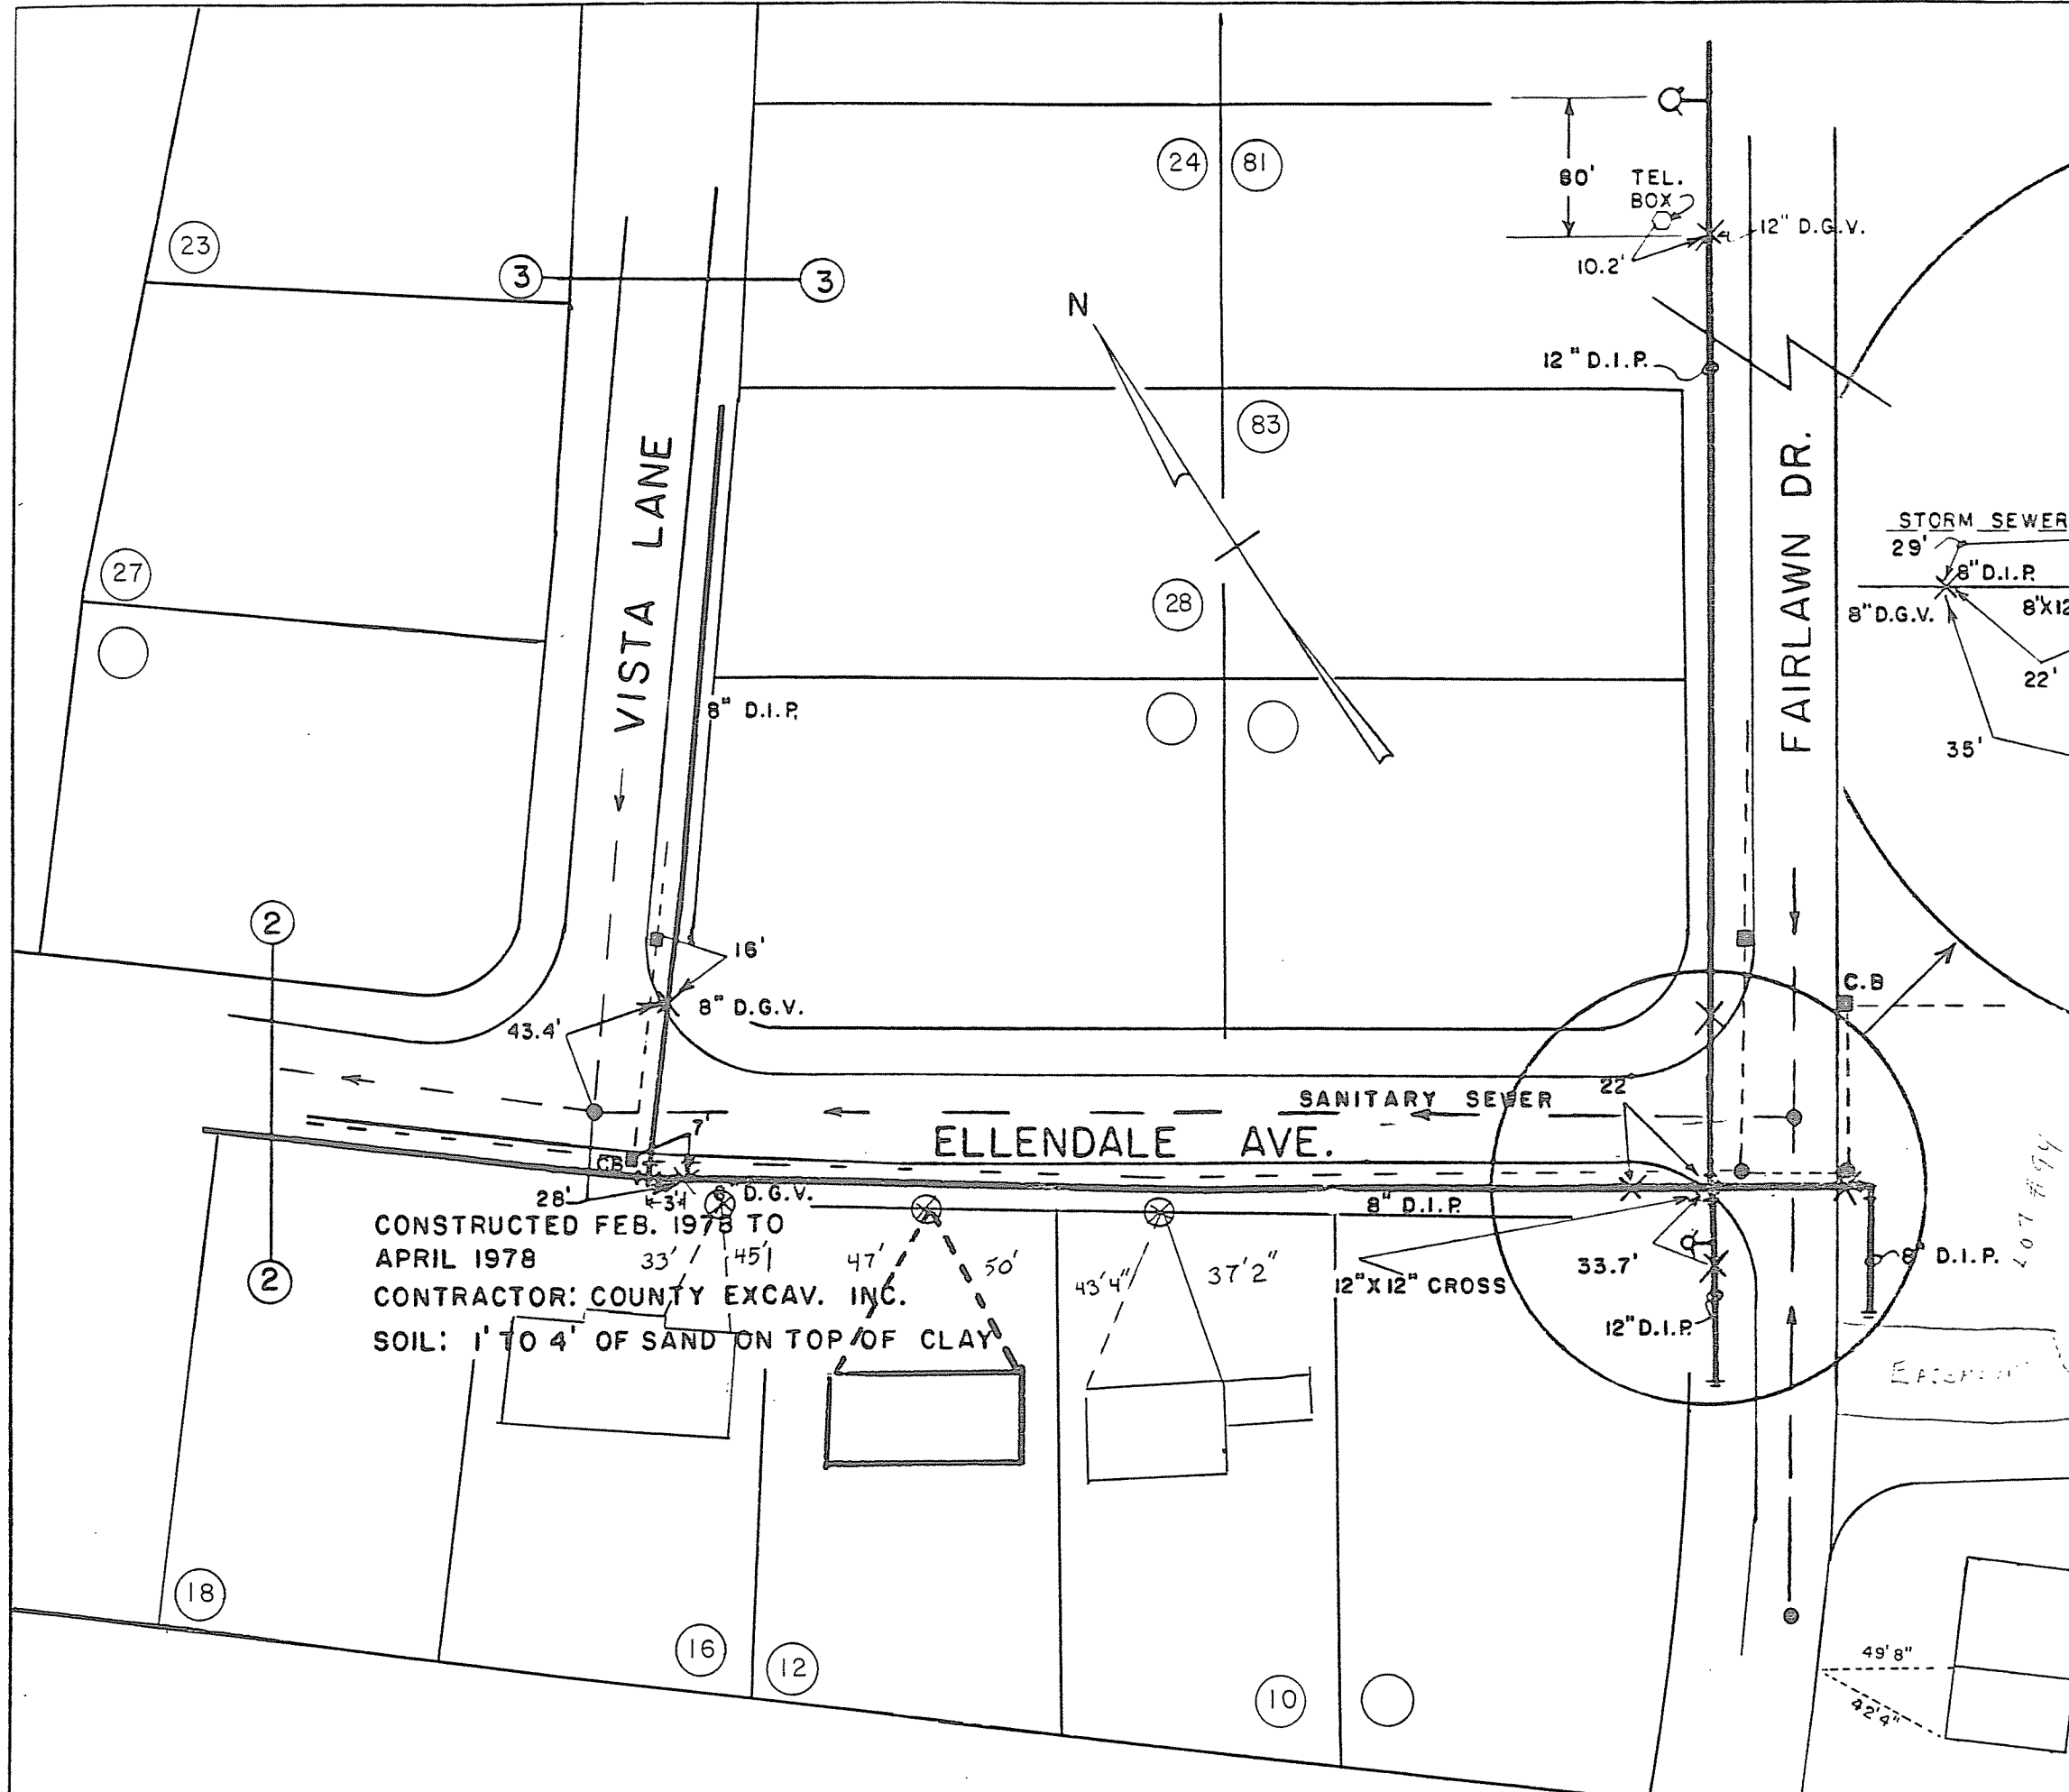

CONSTRUCTED FEB. 1978 TO
 APRIL 1978
 CONTRACTOR: COUNTY EXCAV. INC.
 SOIL: 1' TO 4' OF SAND ON TOP OF CLAY

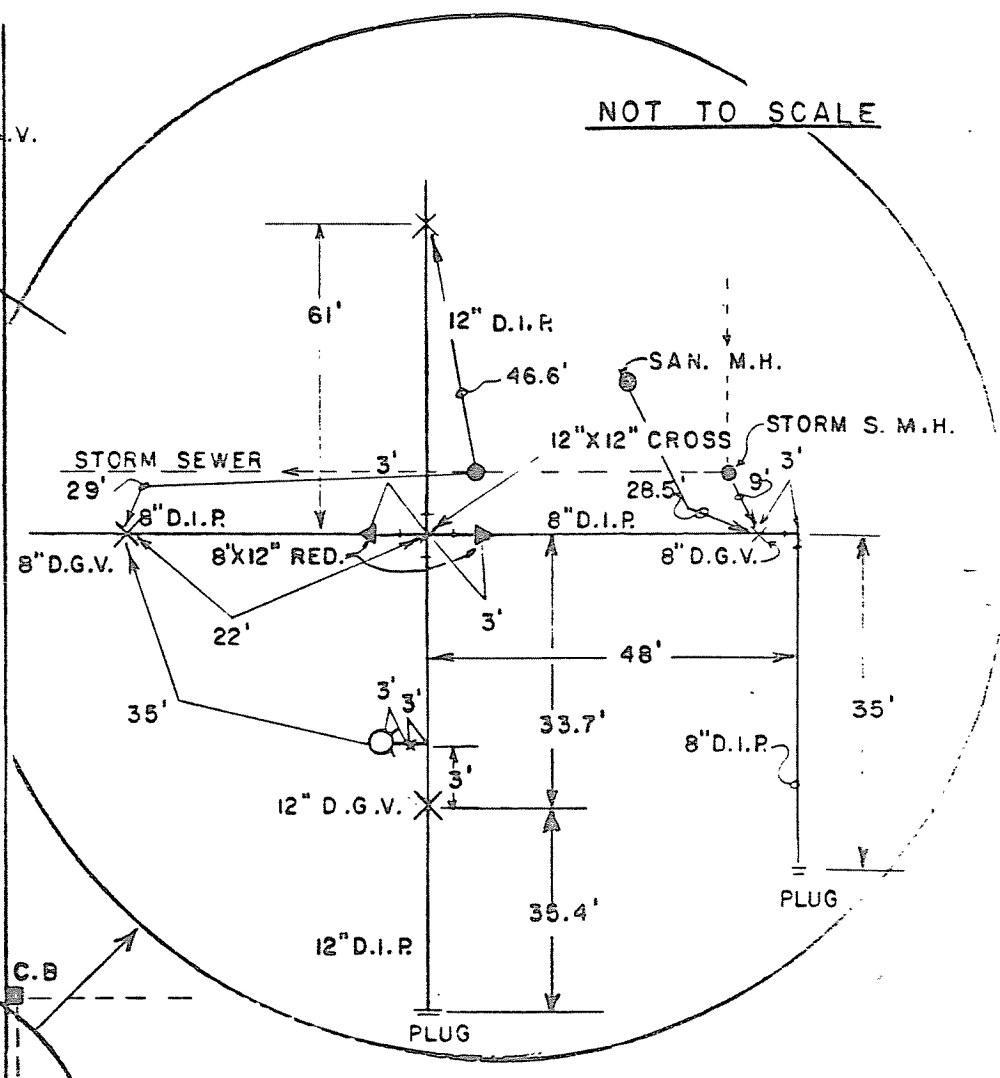

FAIRLAWN DR.
 ELLENDALE AVE.
 SKYCREST
 WATER DISTRICT NO. 1
 TOWN OF BETHLEHEM
 RECORD OF INSTALLATION
 SCALE: 1" = 50' APRIL 1978
 J. KENNETH FRASER & ASSOCIATES, P.C.
 CONSULTING ENGINEERS RENSSELAER, N.Y.

DRAWN BY: H.P.J.
 CHECKED BY: W.T.B.