

FERNBANK AVENUE EAST

WATER DISTRICT NO. 1

TOWN OF BETHLEHEM


RECORD OF INSTALLATION

TOWN OF BETHLEHEM ENGINEERING

DEPARTMENT

SCALE: 1" = 50' JANUARY, 1983

DWN. BY: PDH

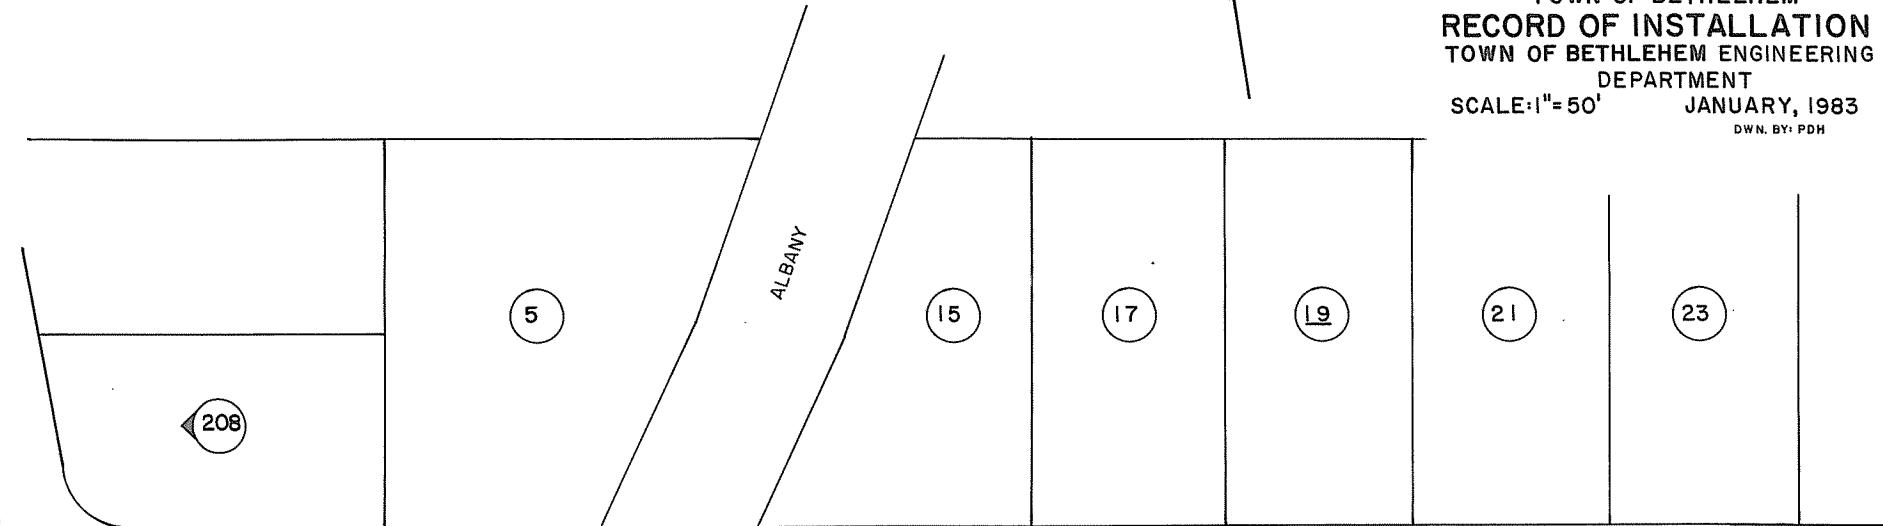

FERNBANK

AVENUE

EAST

