


FERNBANK AVENUE
WATER DISTRICT NO. I
TOWN OF BETHLEHEM
RECORD OF INSTALLATION
TOWN OF BETHLEHEM ENGINEERING
DEPARTMENT
SCALE: 1"=50' FEBRUARY, 1982
DWN. BY: PDH

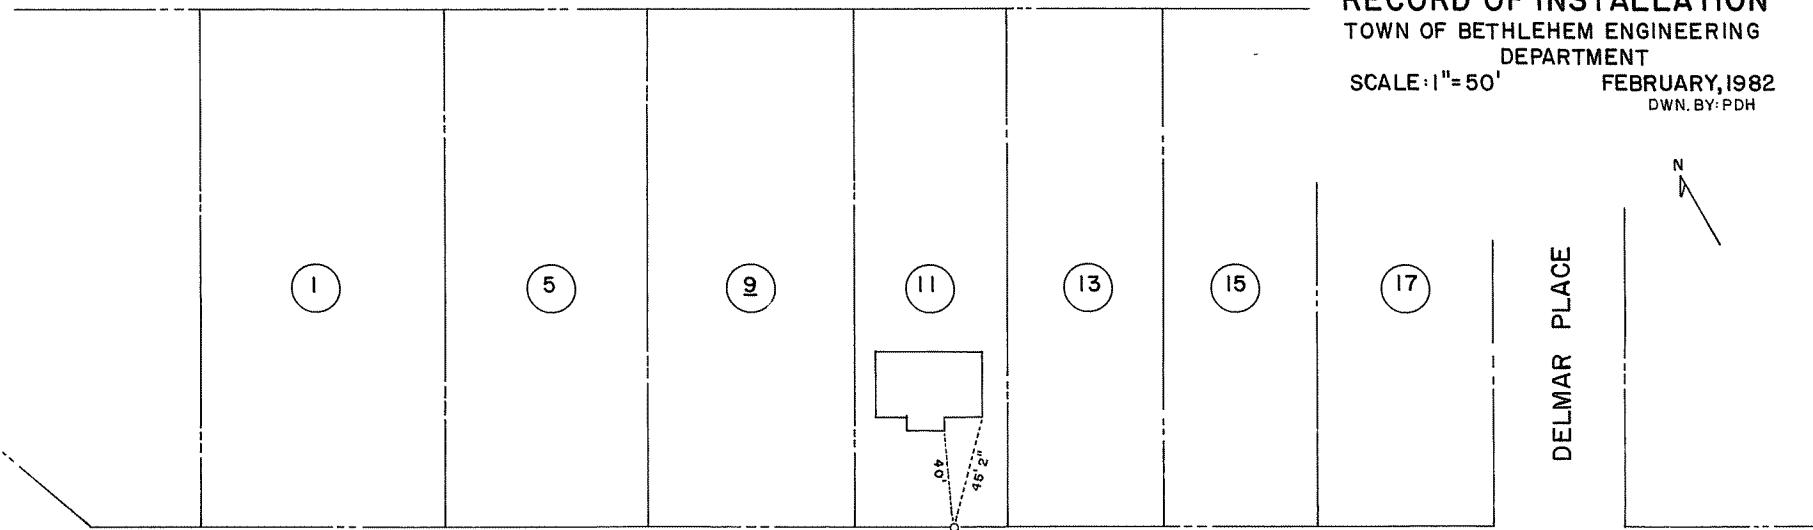

FERNBANK

AVENUE

WINNE
ROAD

LOUISE
STREET