

FERNBANK AVENUE  
WATER DISTRICT NO. 1  
TOWN OF BETHLEHEM  
RECORD OF INSTALLATION  
TOWN OF BETHLEHEM ENGINEERING  
DEPARTMENT  
SCALE: 1"=50' FEBRUARY, 1982  
DWN. BY: PDH



DELMAR PLACE

17

25

29

31



33

35

37

39

41

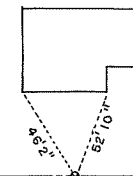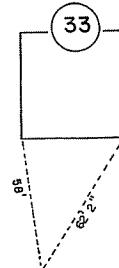

FERNBANK

AVENUE

14

LOUISE STREET

20

26

32

34

KIETH ROAD

36

38

40