



FERNBANK AVENUE
WATER DISTRICT NO. 1
TOWN OF BETHLEHEM
RECORD OF INSTALLATION
TOWN OF BETHLEHEM ENGINEERING
DEPARTMENT
SCALE: 1"=50' FEBRUARY, 1982
DWN. BY: PDH

N

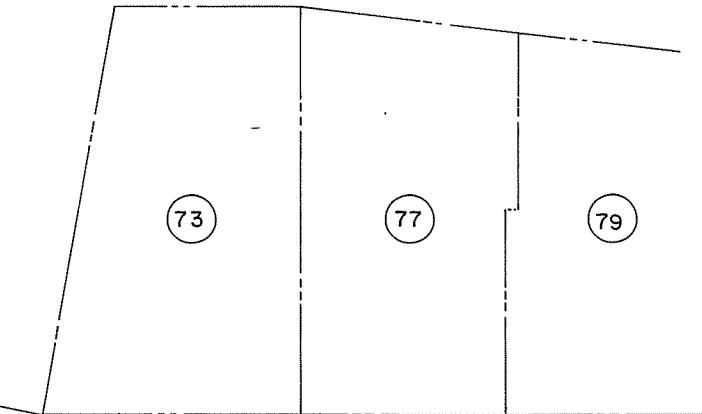

FERNBANK

BROOKSIDE AVENUE

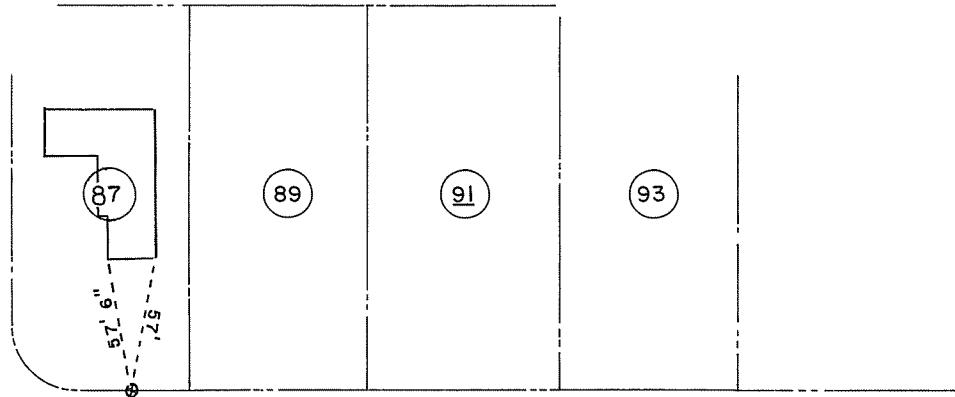

AVENUE

