

FERNBANK AVENUE
WATER DISTRICT NO. 1
TOWN OF BETHLEHEM
RECORD OF INSTALLATION
TOWN OF BETHLEHEM ENGINEERING
DEPARTMENT
SCALE: 1"= 50' FEBRUARY, 1982
DWN. BY: PDH



AVENUE

43

53

55

57

59

65

69

71



FERNBANK

AVENUE

42

54


56

60

62

68

72

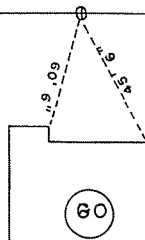

PALMER

JORDAN BOULEVARD