


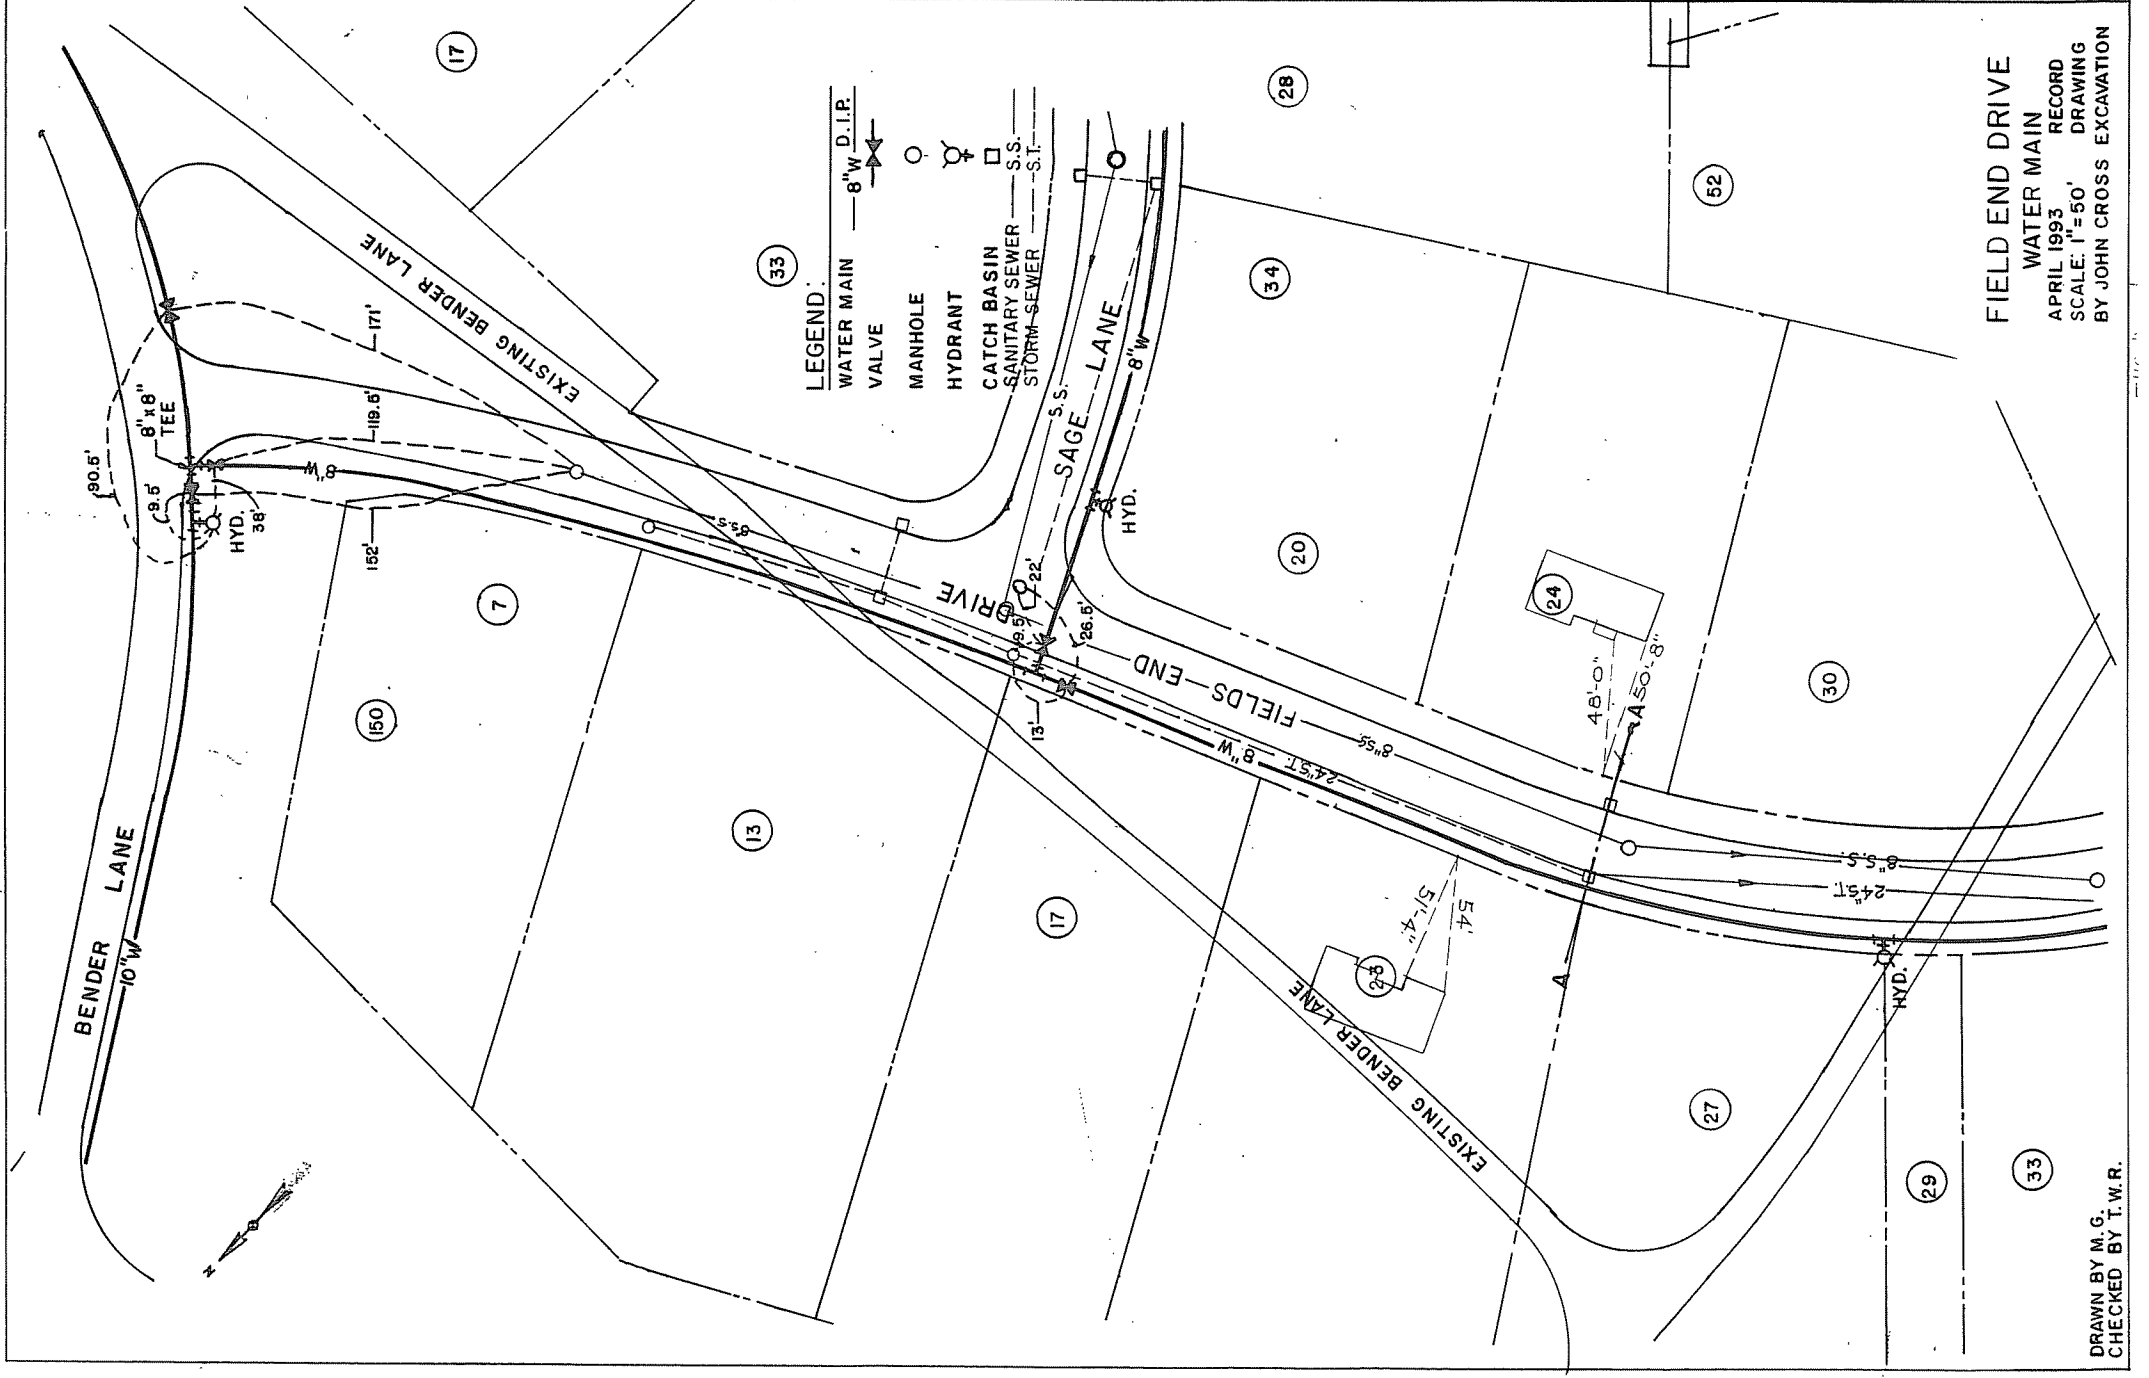

- LEGEND:
- WATER MAIN — 8" W D.I.P.
 - VALVE — [Symbol]
 - MANHOLE — [Symbol]
 - HYDRANT — [Symbol]
 - CATCH BASIN — [Symbol]
 - SANITARY SEWER — S.S.
 - STORM SEWER — S.T.

FIELD END DRIVE
 WATER MAIN
 APRIL 1993
 SCALE: 1" = 50'
 RECORD
 DRAWING
 BY JOHN CROSS EXCAVATION

DRAWN BY M. G.
 CHECKED BY T. W. R.