


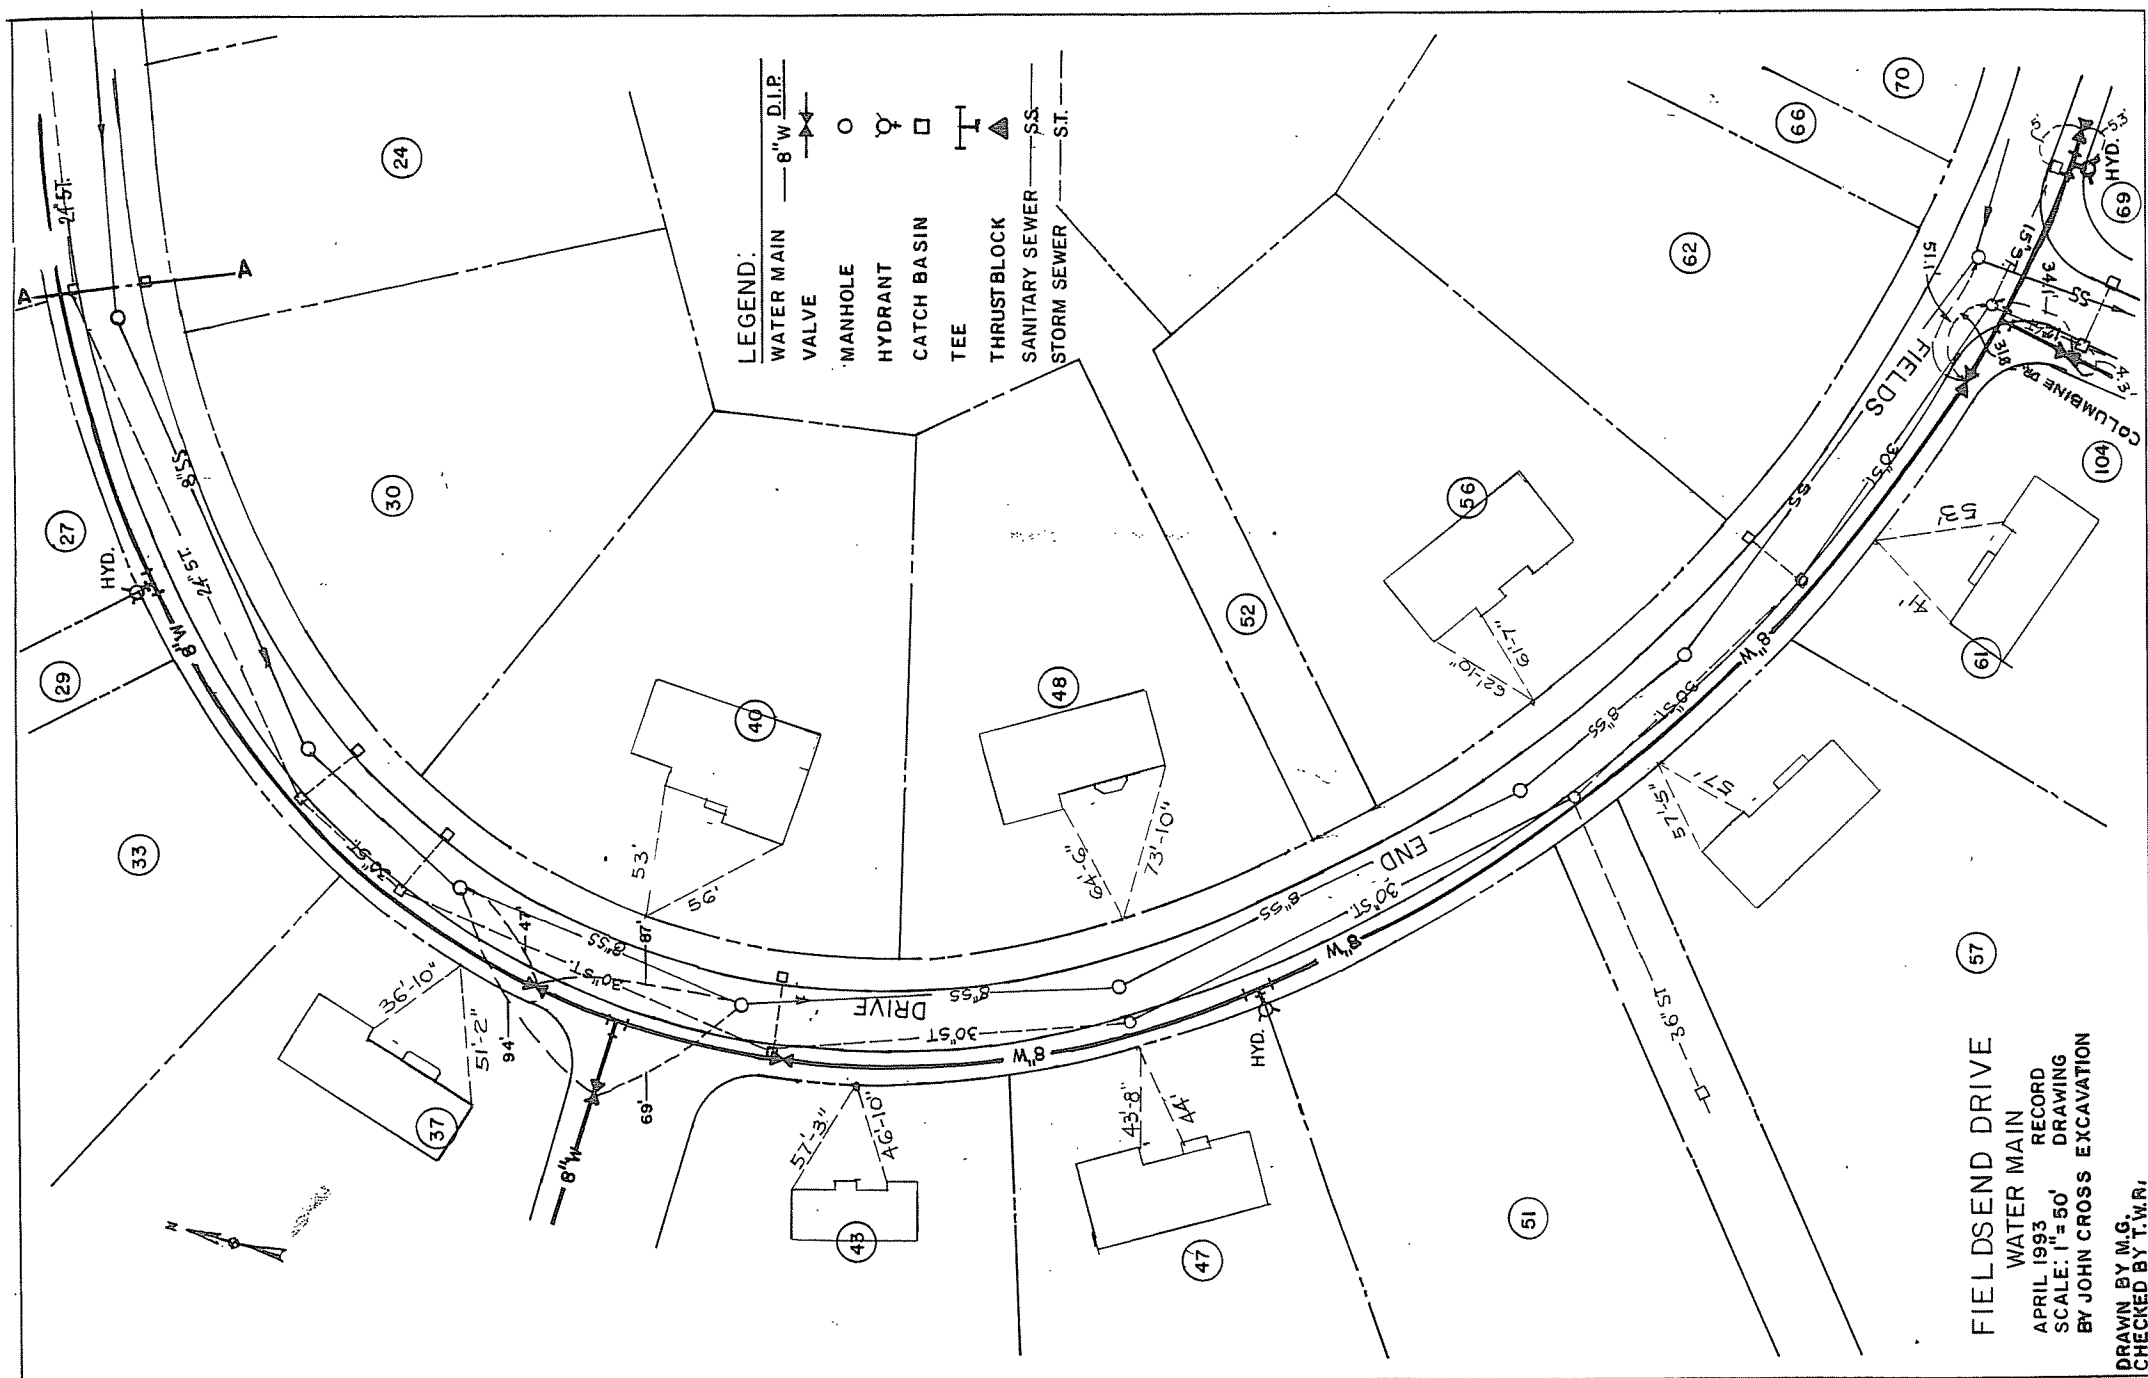

LEGEND:

WATER MAIN	8" W D.I.P.
VALVE	
MANHOLE	
HYDRANT	
CATCH BASIN	
TEE	
THRUST BLOCK	
SANITARY SEWER	SS
STORM SEWER	ST

FIELDSEND DRIVE

WATER MAIN

APRIL 1993 RECORD

SCALE: 1"=50' DRAWING
BY JOHN CROSS EXCAVATION

DRAWN BY M.G.
CHECKED BY T.W.R.