


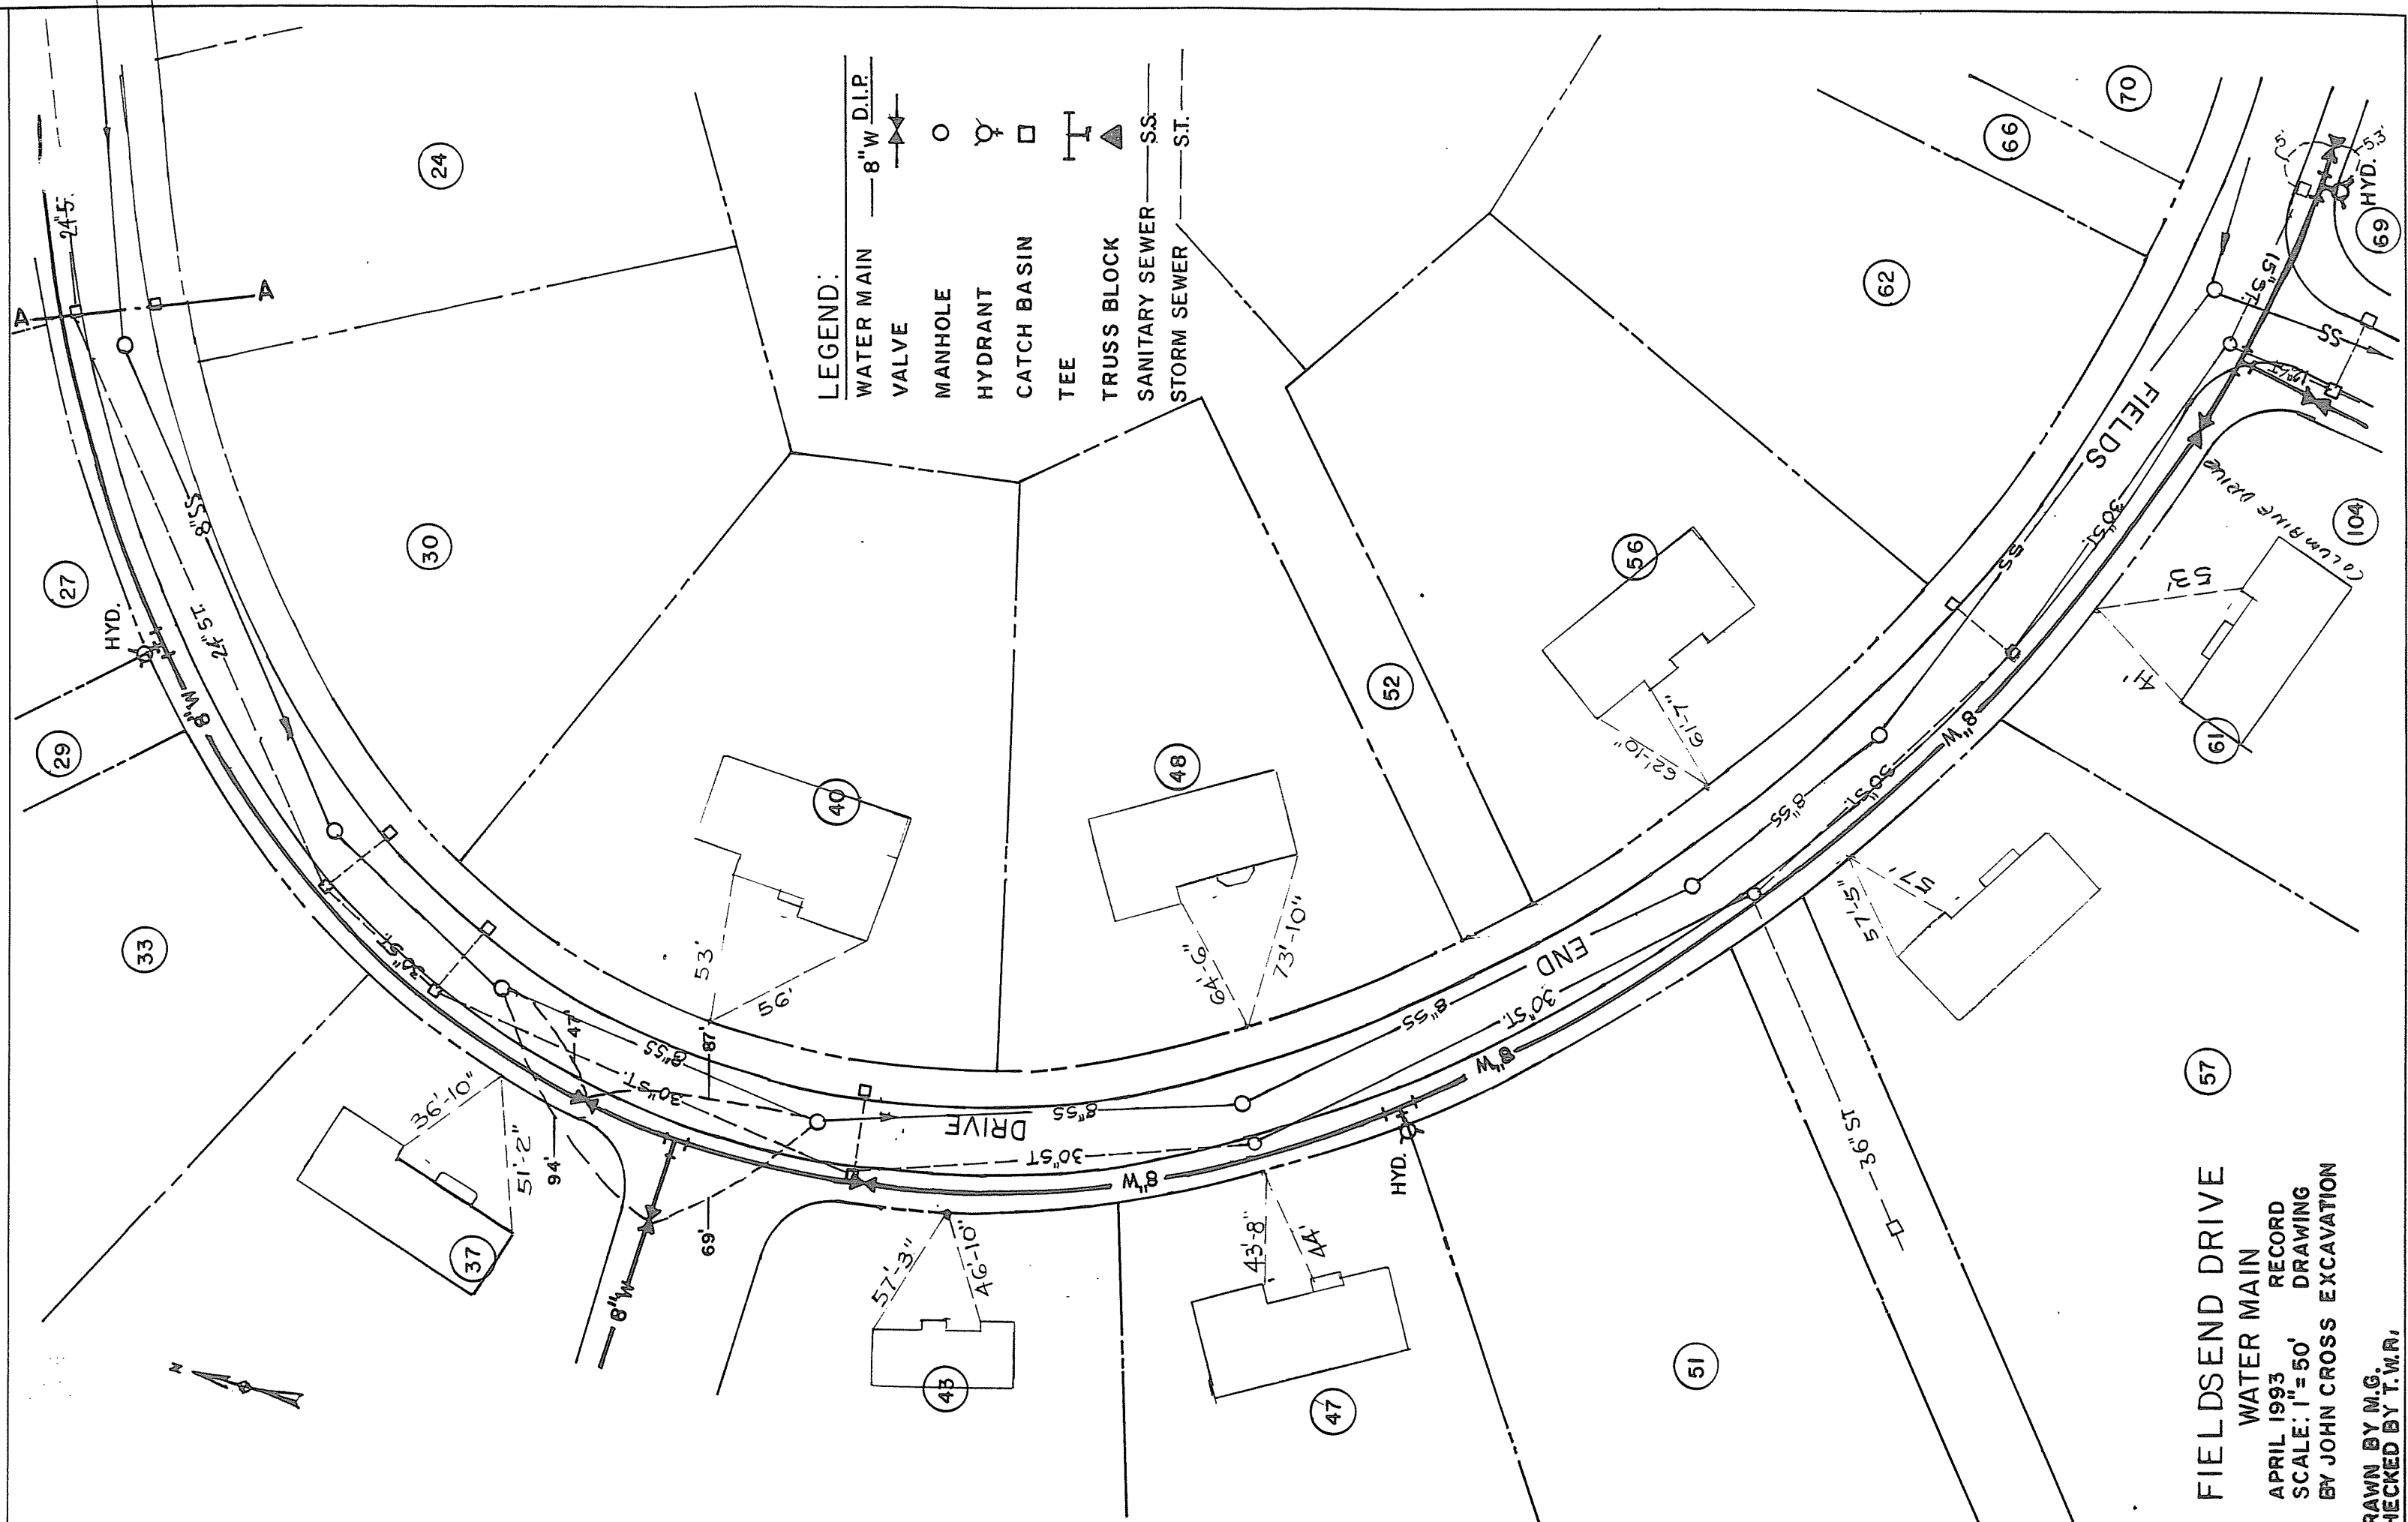

LEGEND:

WATER MAIN	8" W. D.I.P.
VALVE	○
MANHOLE	○
HYDRANT	○
CATCH BASIN	□
TEE	T
TRUSS BLOCK	▲
SANITARY SEWER	SS
STORM SEWER	ST

FIELSEND DRIVE (57)
WATER MAIN
APRIL 1993 RECORD
SCALE: 1" = 50' DRAWING
BY JOHN CROSS EXCAVATION
DRAWN BY M.G.
CHECKED BY T.W.R.