


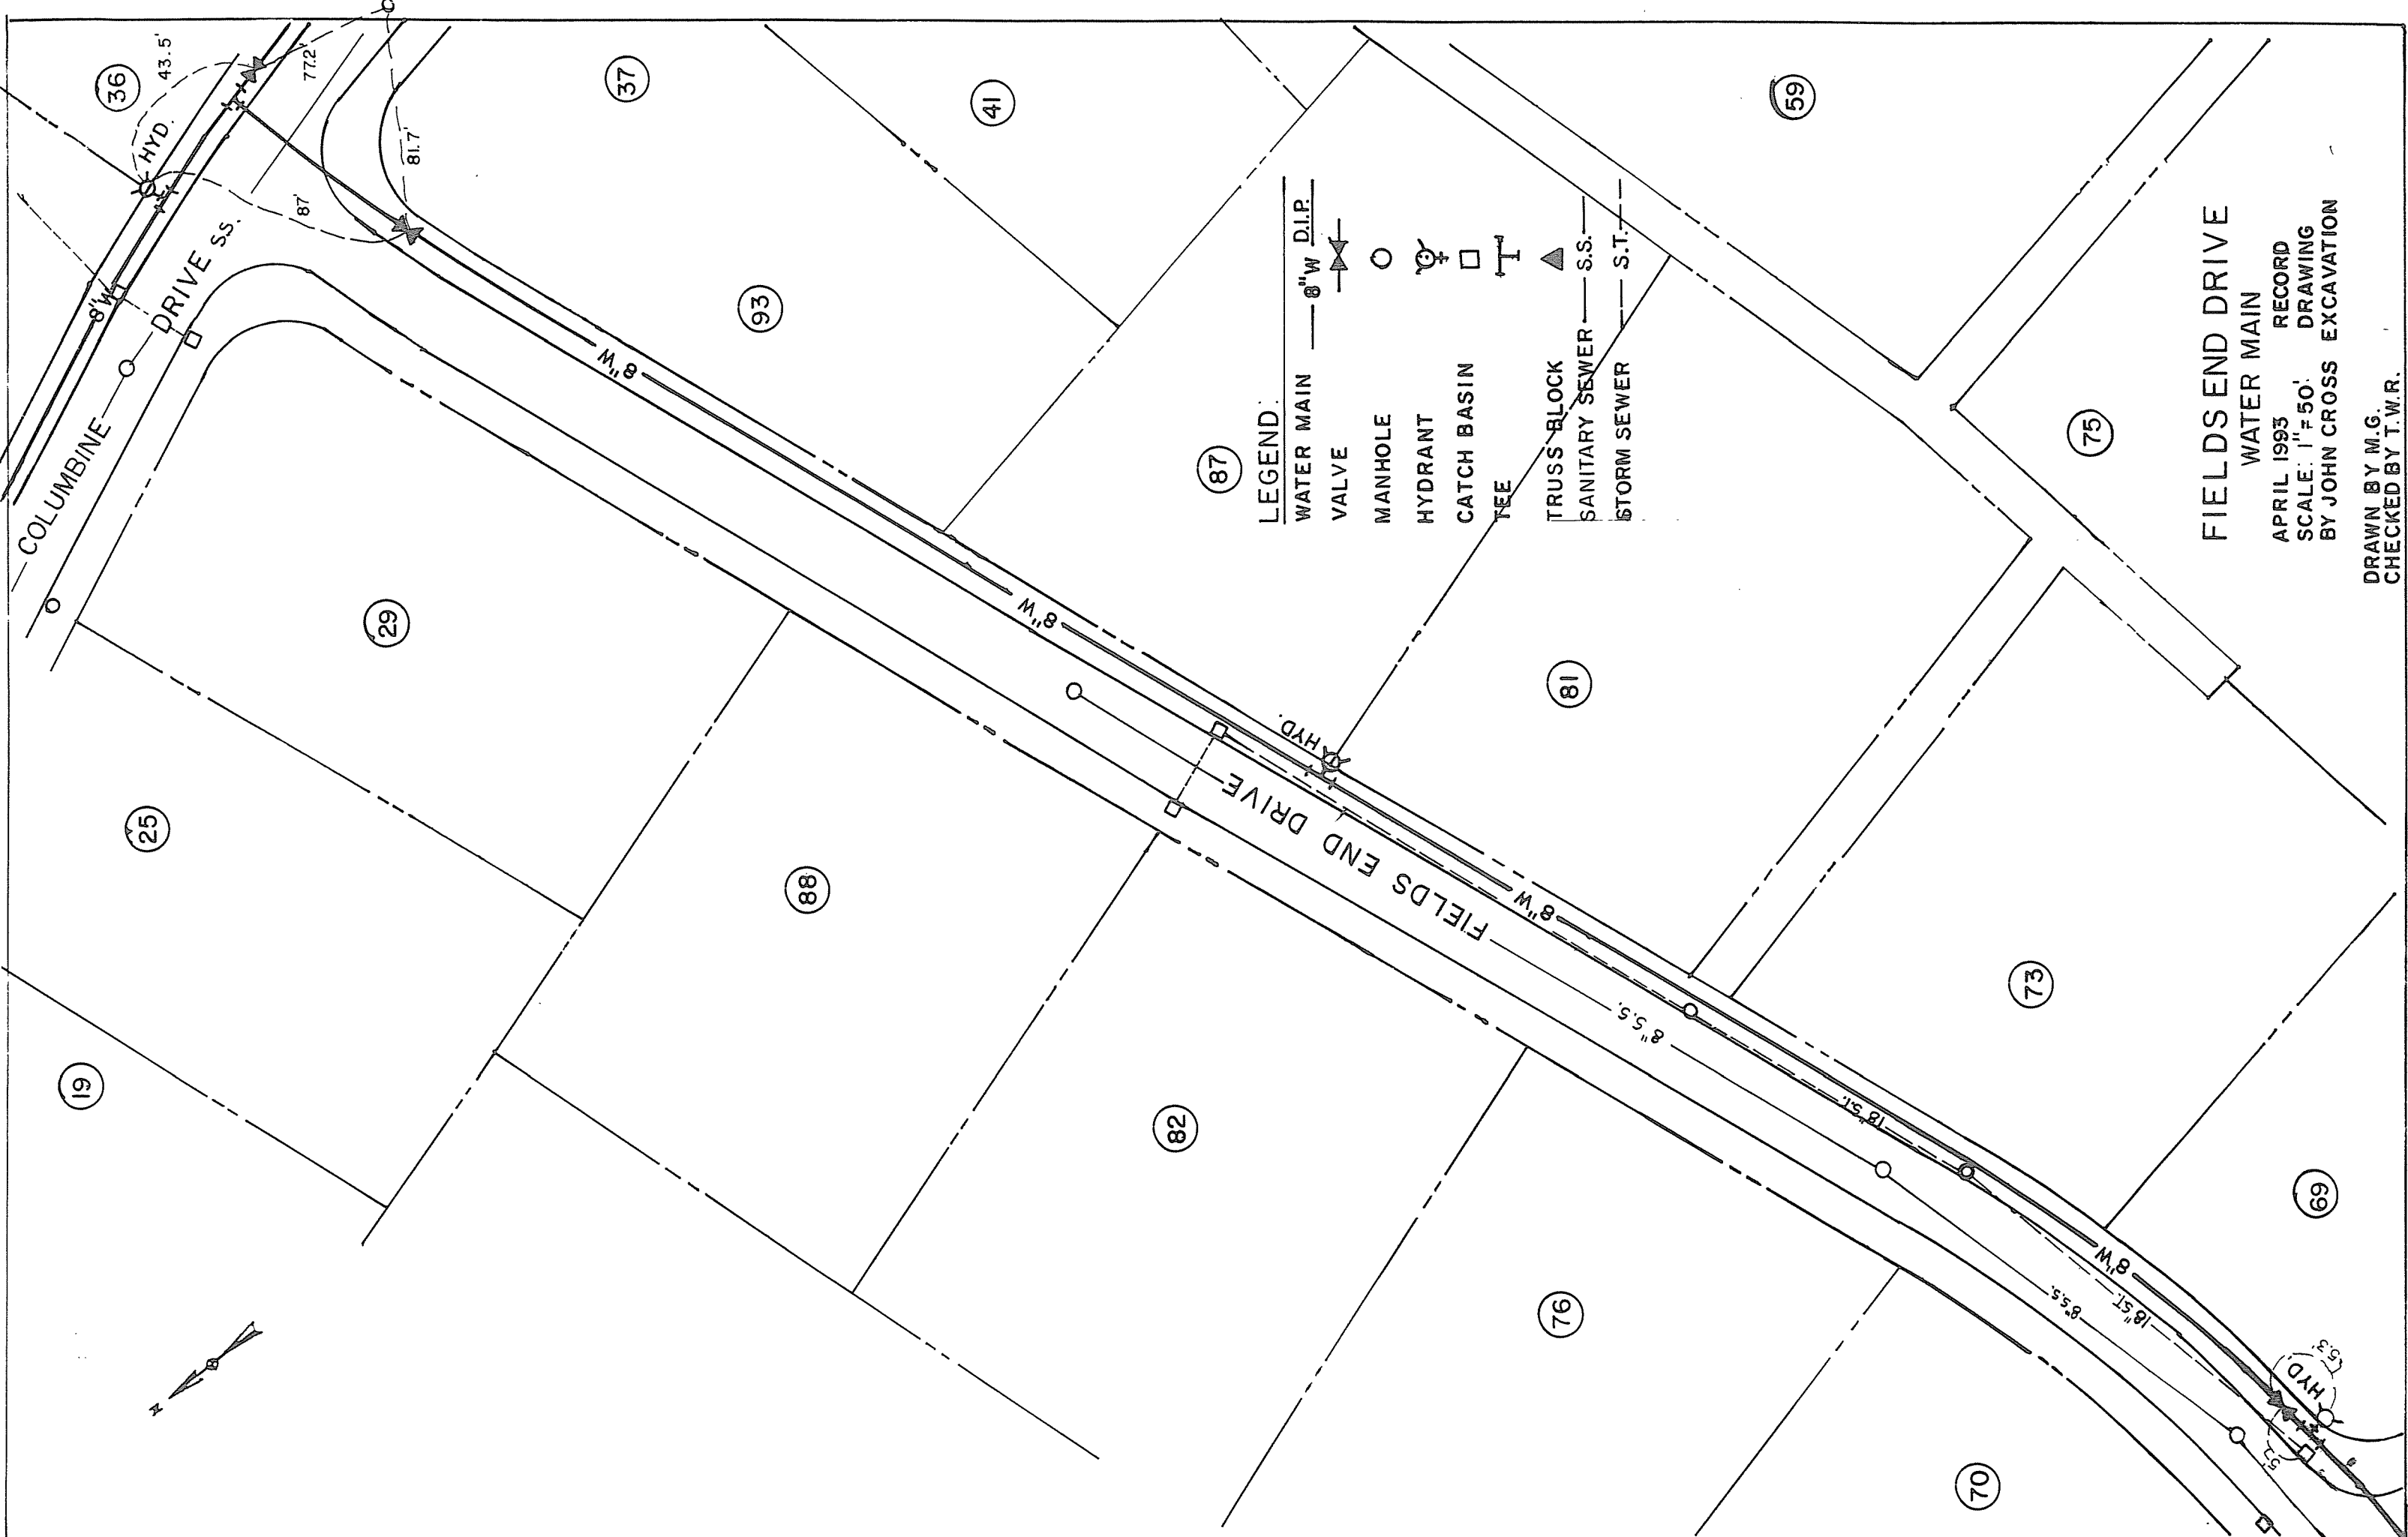

LEGEND:

WATER MAIN	8" W	D.I.P.
VALVE		
MANHOLE		
HYDRANT		
CATCH BASIN		
TEE		
TRUSS BLOCK		
SANITARY SEWER	S.S.	
STORM SEWER	S.T.	

FIELDS END DRIVE
WATER MAIN
APRIL 1993
SCALE: 1" = 50'
BY JOHN CROSS
DRAWN BY M.G.
CHECKED BY T.W.R.
RECORD
DRAWING
EXCAVATION
The Meadows Subdivision