


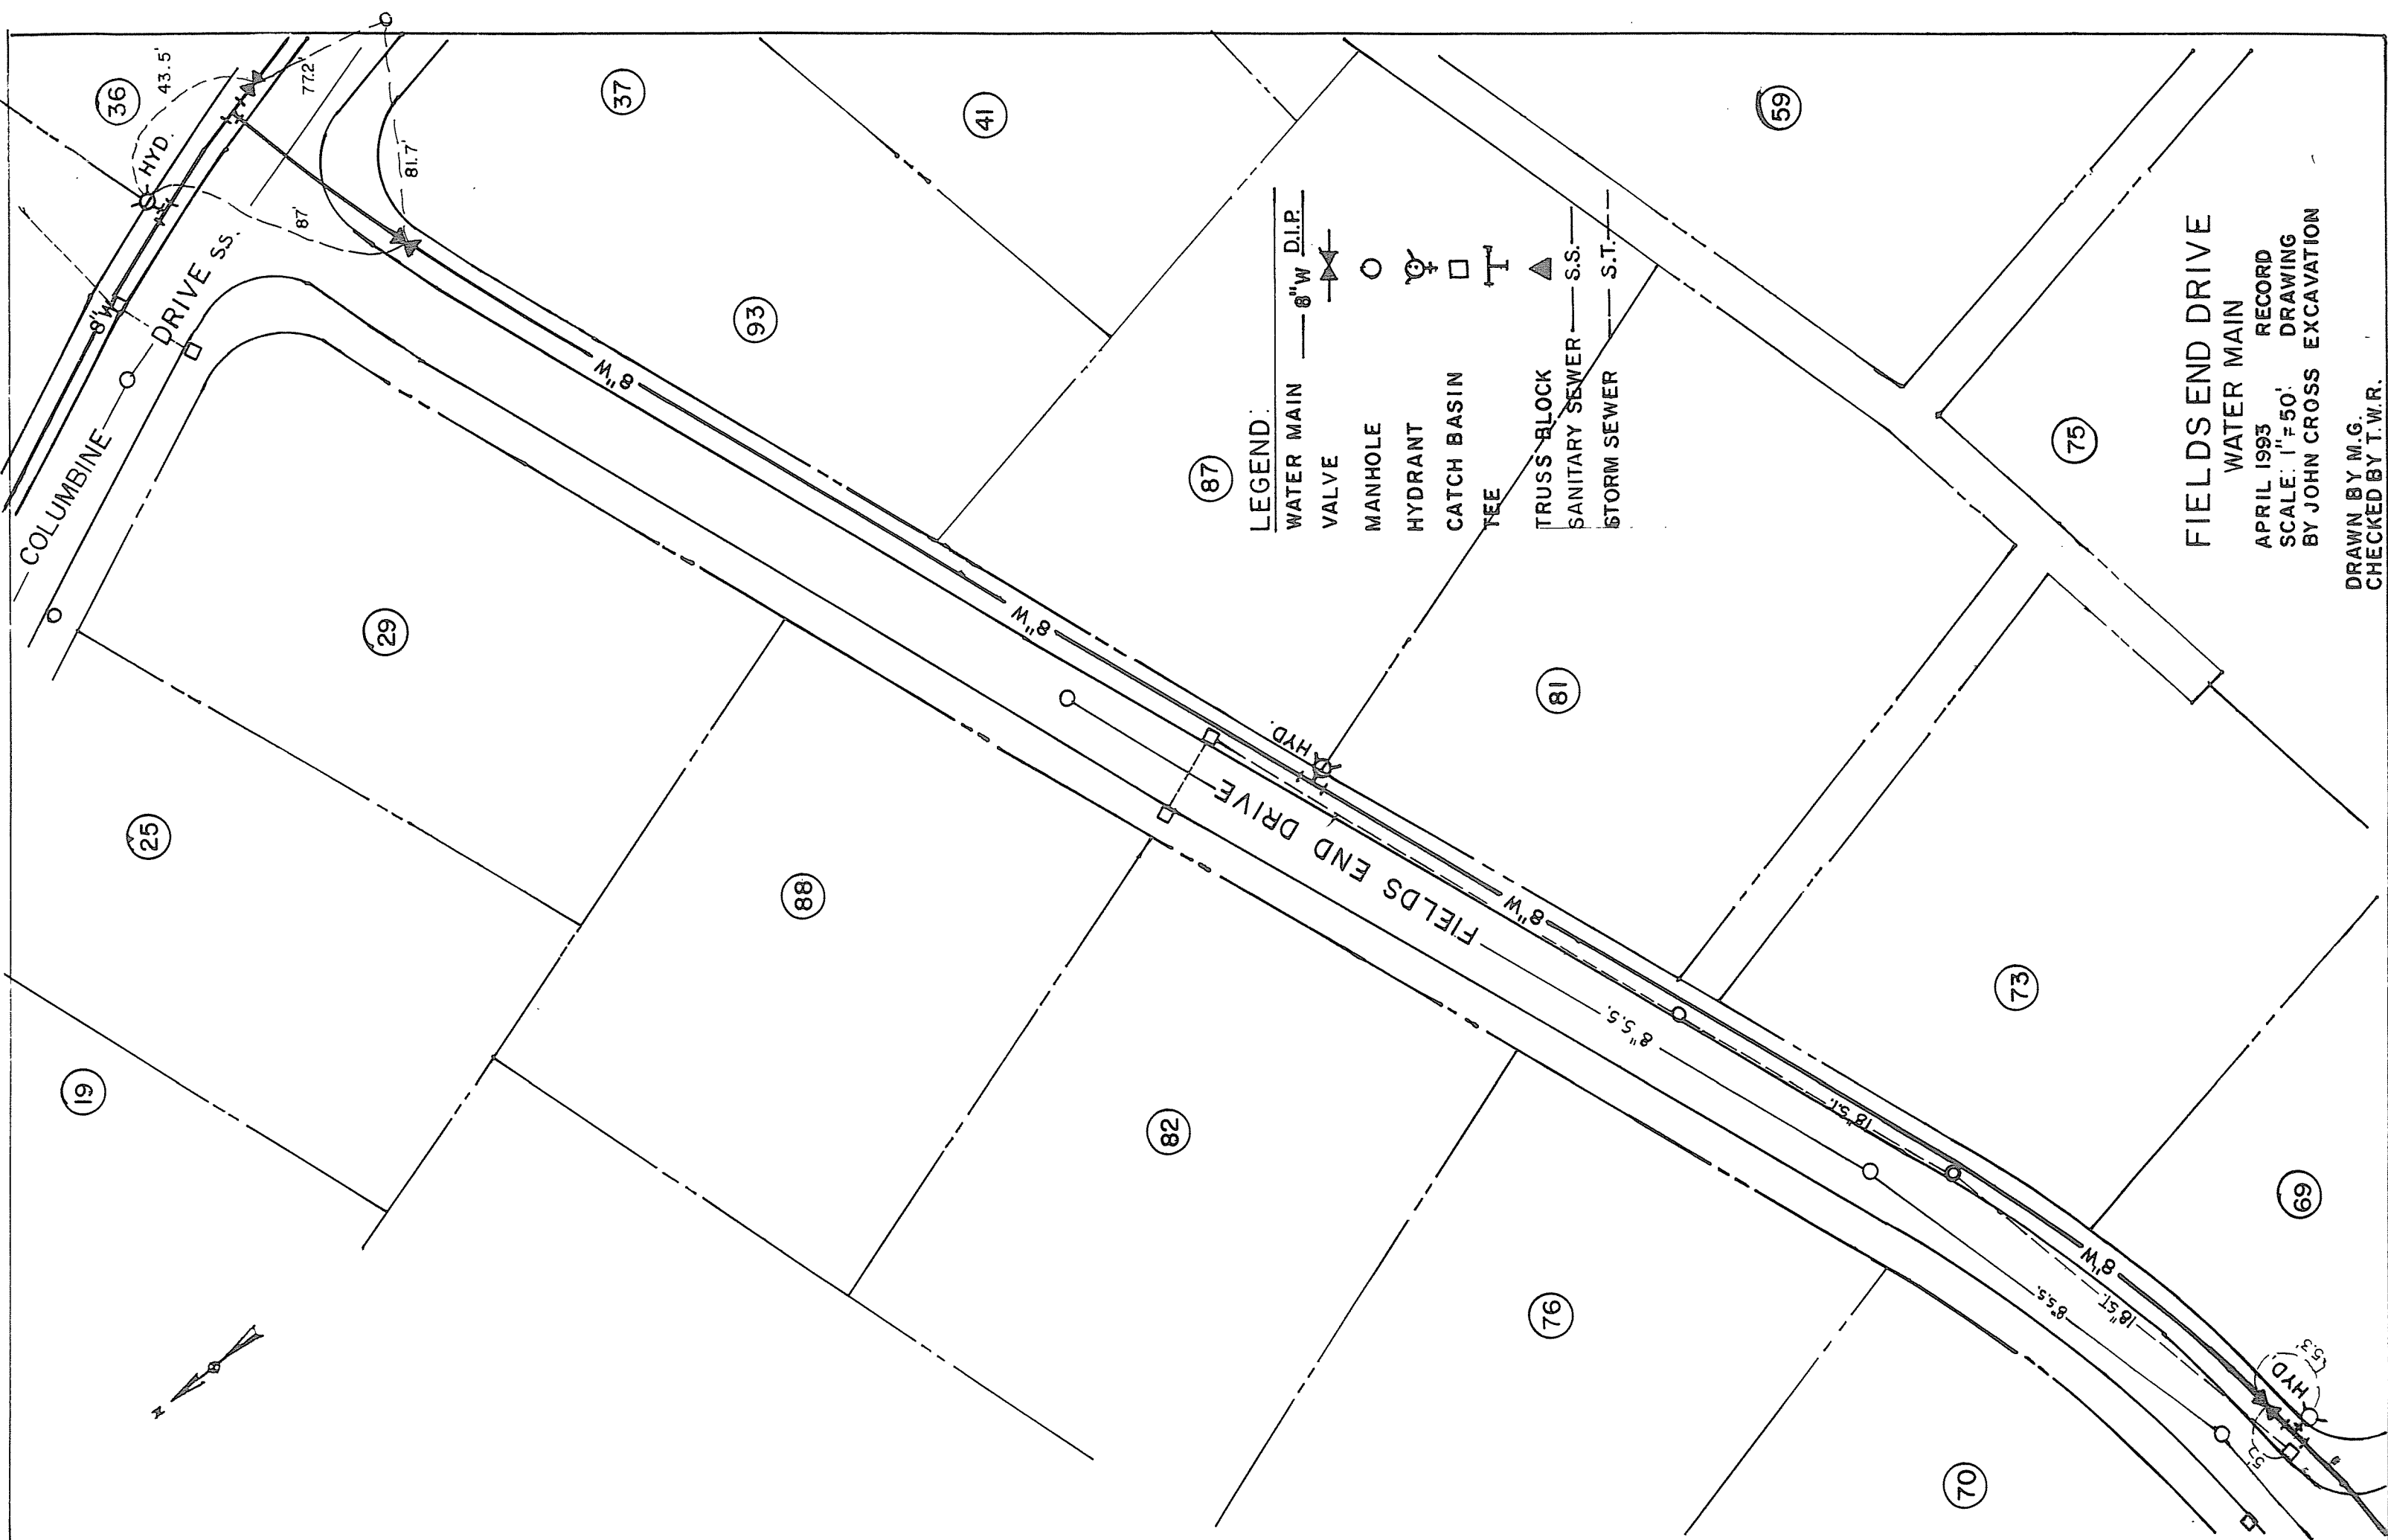

(87)

- LEGEND:
- WATER MAIN — 8" W D.I.P.
 - VALVE — [Valve Symbol]
 - MANHOLE — [Manhole Symbol]
 - HYDRANT — [Hydrant Symbol]
 - CATCH BASIN — [Catch Basin Symbol]
 - TEE — [Tee Symbol]
 - TRUSS BLOCK — [Truss Block Symbol]
 - SANITARY SEWER — S.S. — [Sanitary Sewer Symbol]
 - STORM SEWER — S.T. — [Storm Sewer Symbol]

FIELDSEND DRIVE
WATER MAIN

APRIL 1993 RECORD
SCALE: 1"=50' DRAWING
BY JOHN CROSS EXCAVATION
DRAWN BY M.G.
CHECKED BY T.W.R.
The Meadows Subdivision