


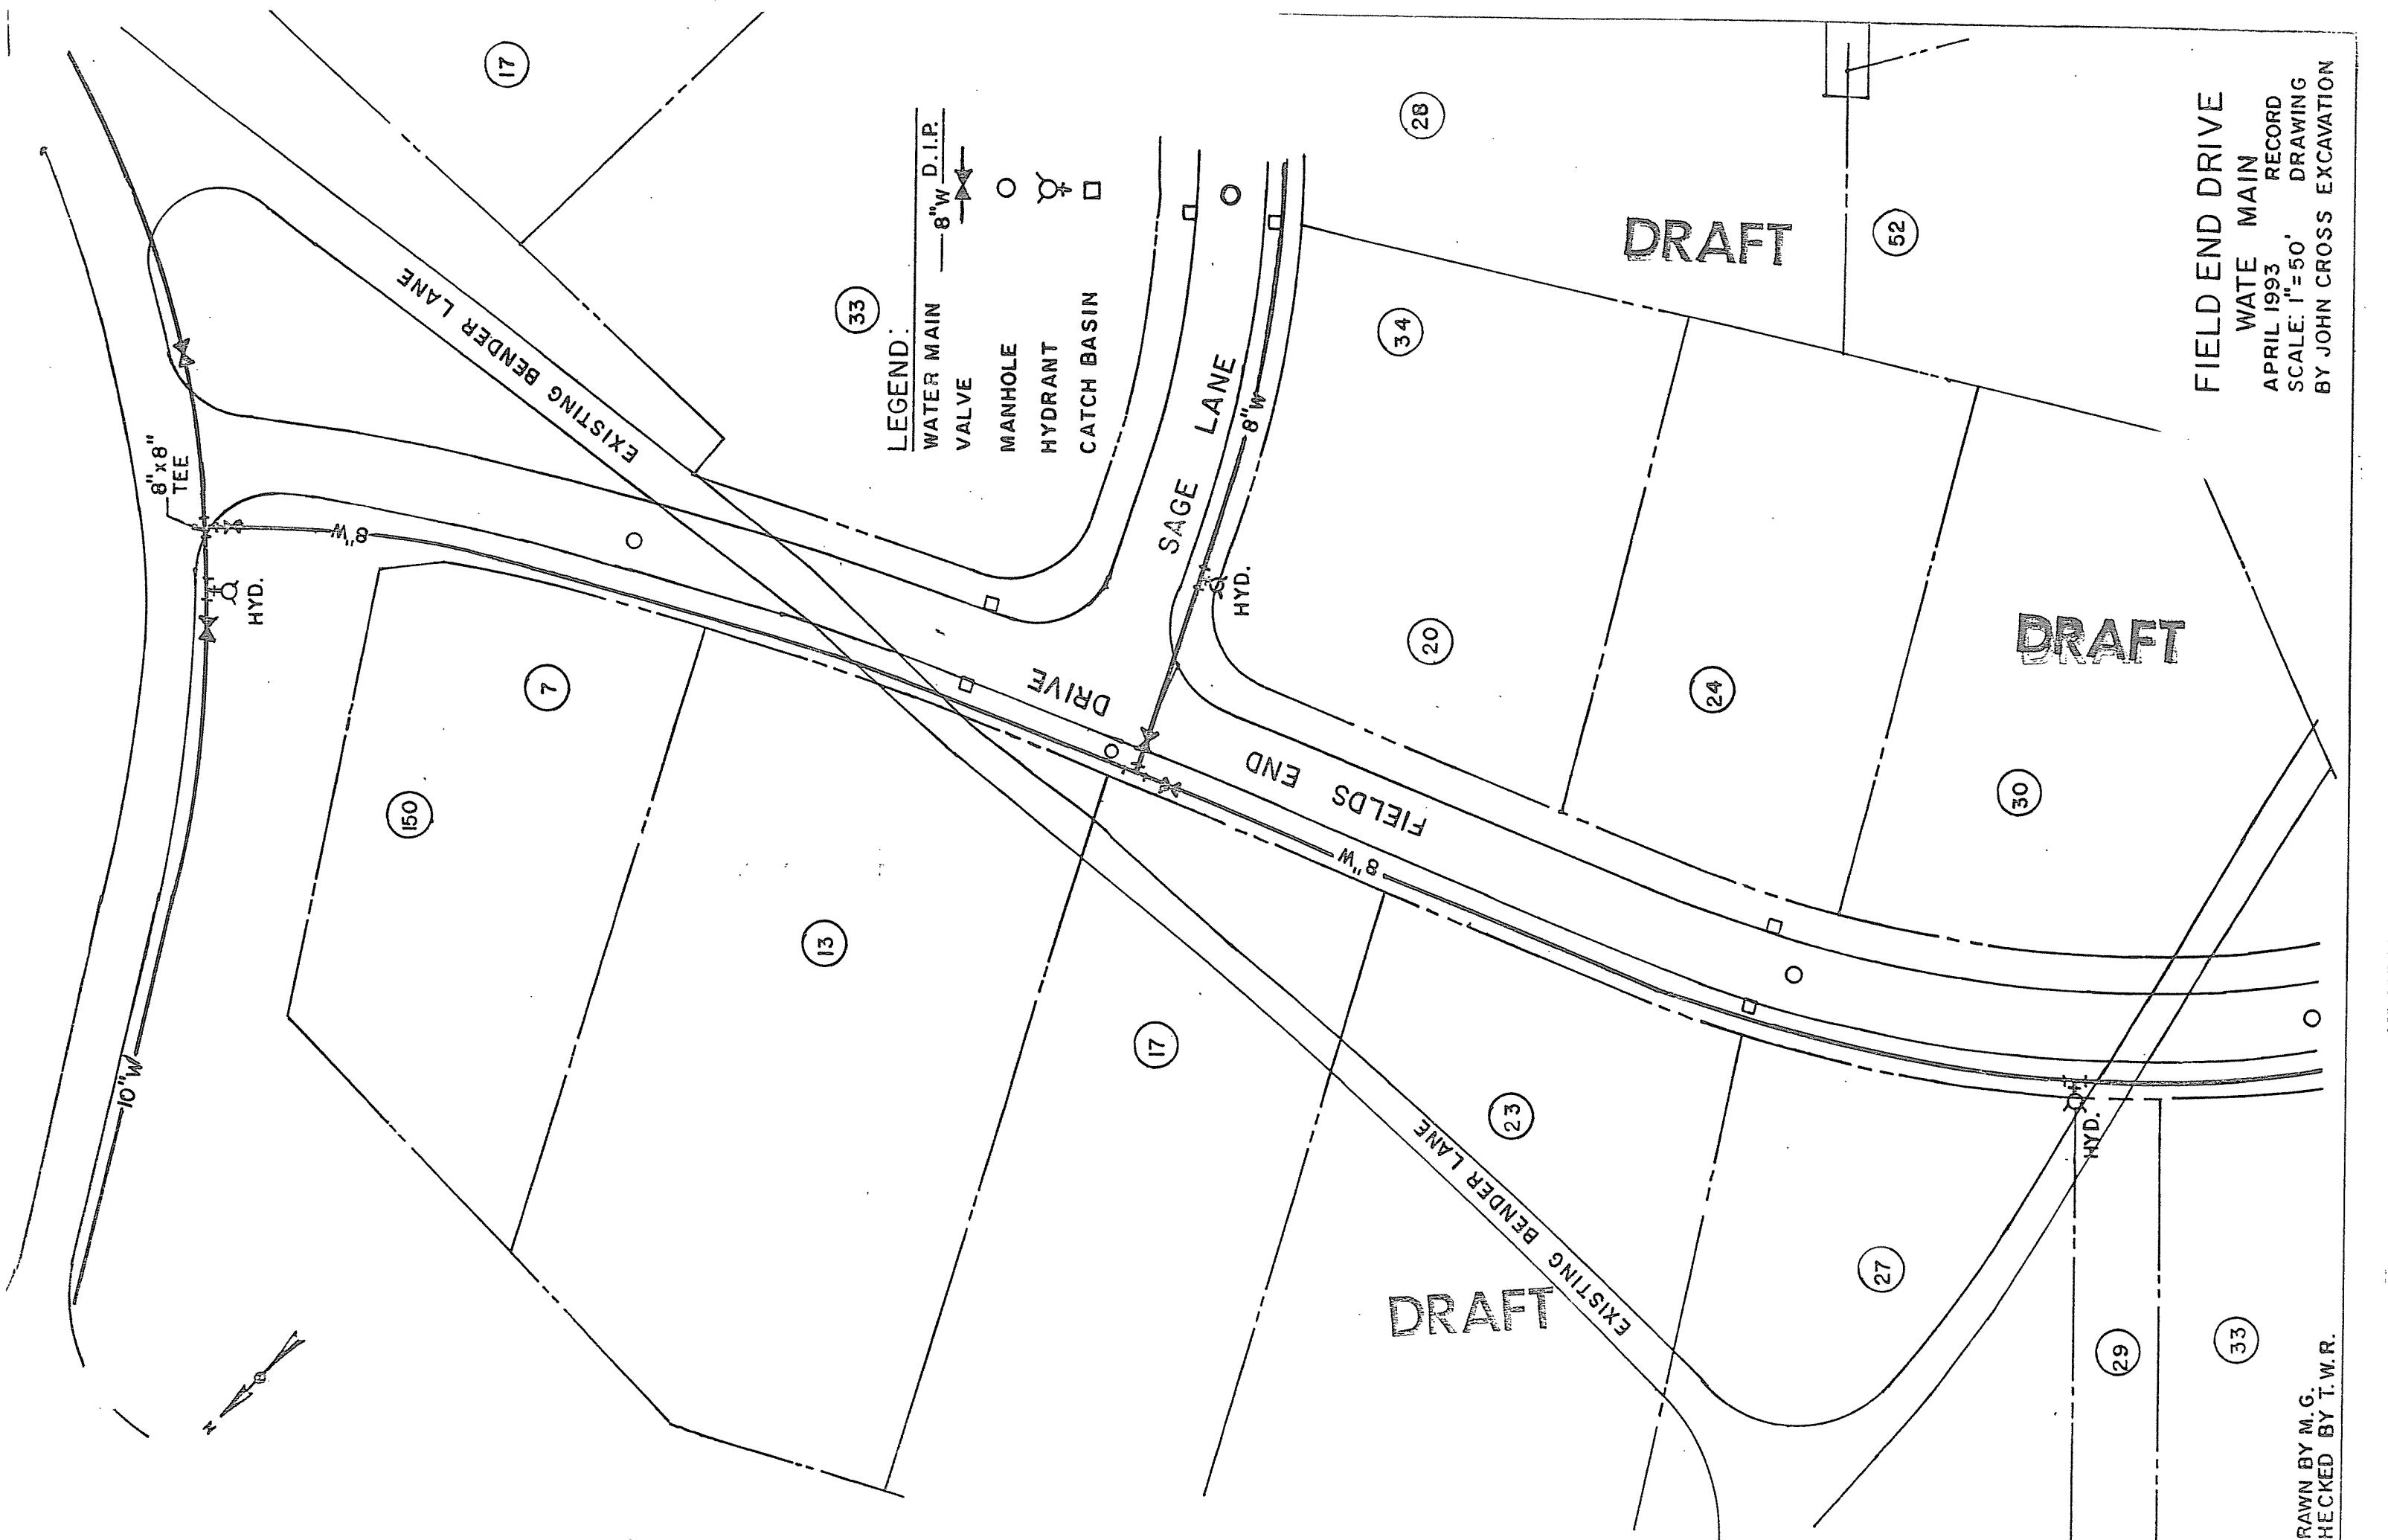

LEGEND:

WATER MAIN	8" W	D.I.P.
VALVE		
MANHOLE		
HYDRANT		
CATCH BASIN		

FIELD END DRIVE
WATE MAIN
APRIL 1993
SCALE: 1"=50'
BY JOHN CROSS EXCAVATION

DRAWN BY M.G.
CHECKED BY T.W.R.