


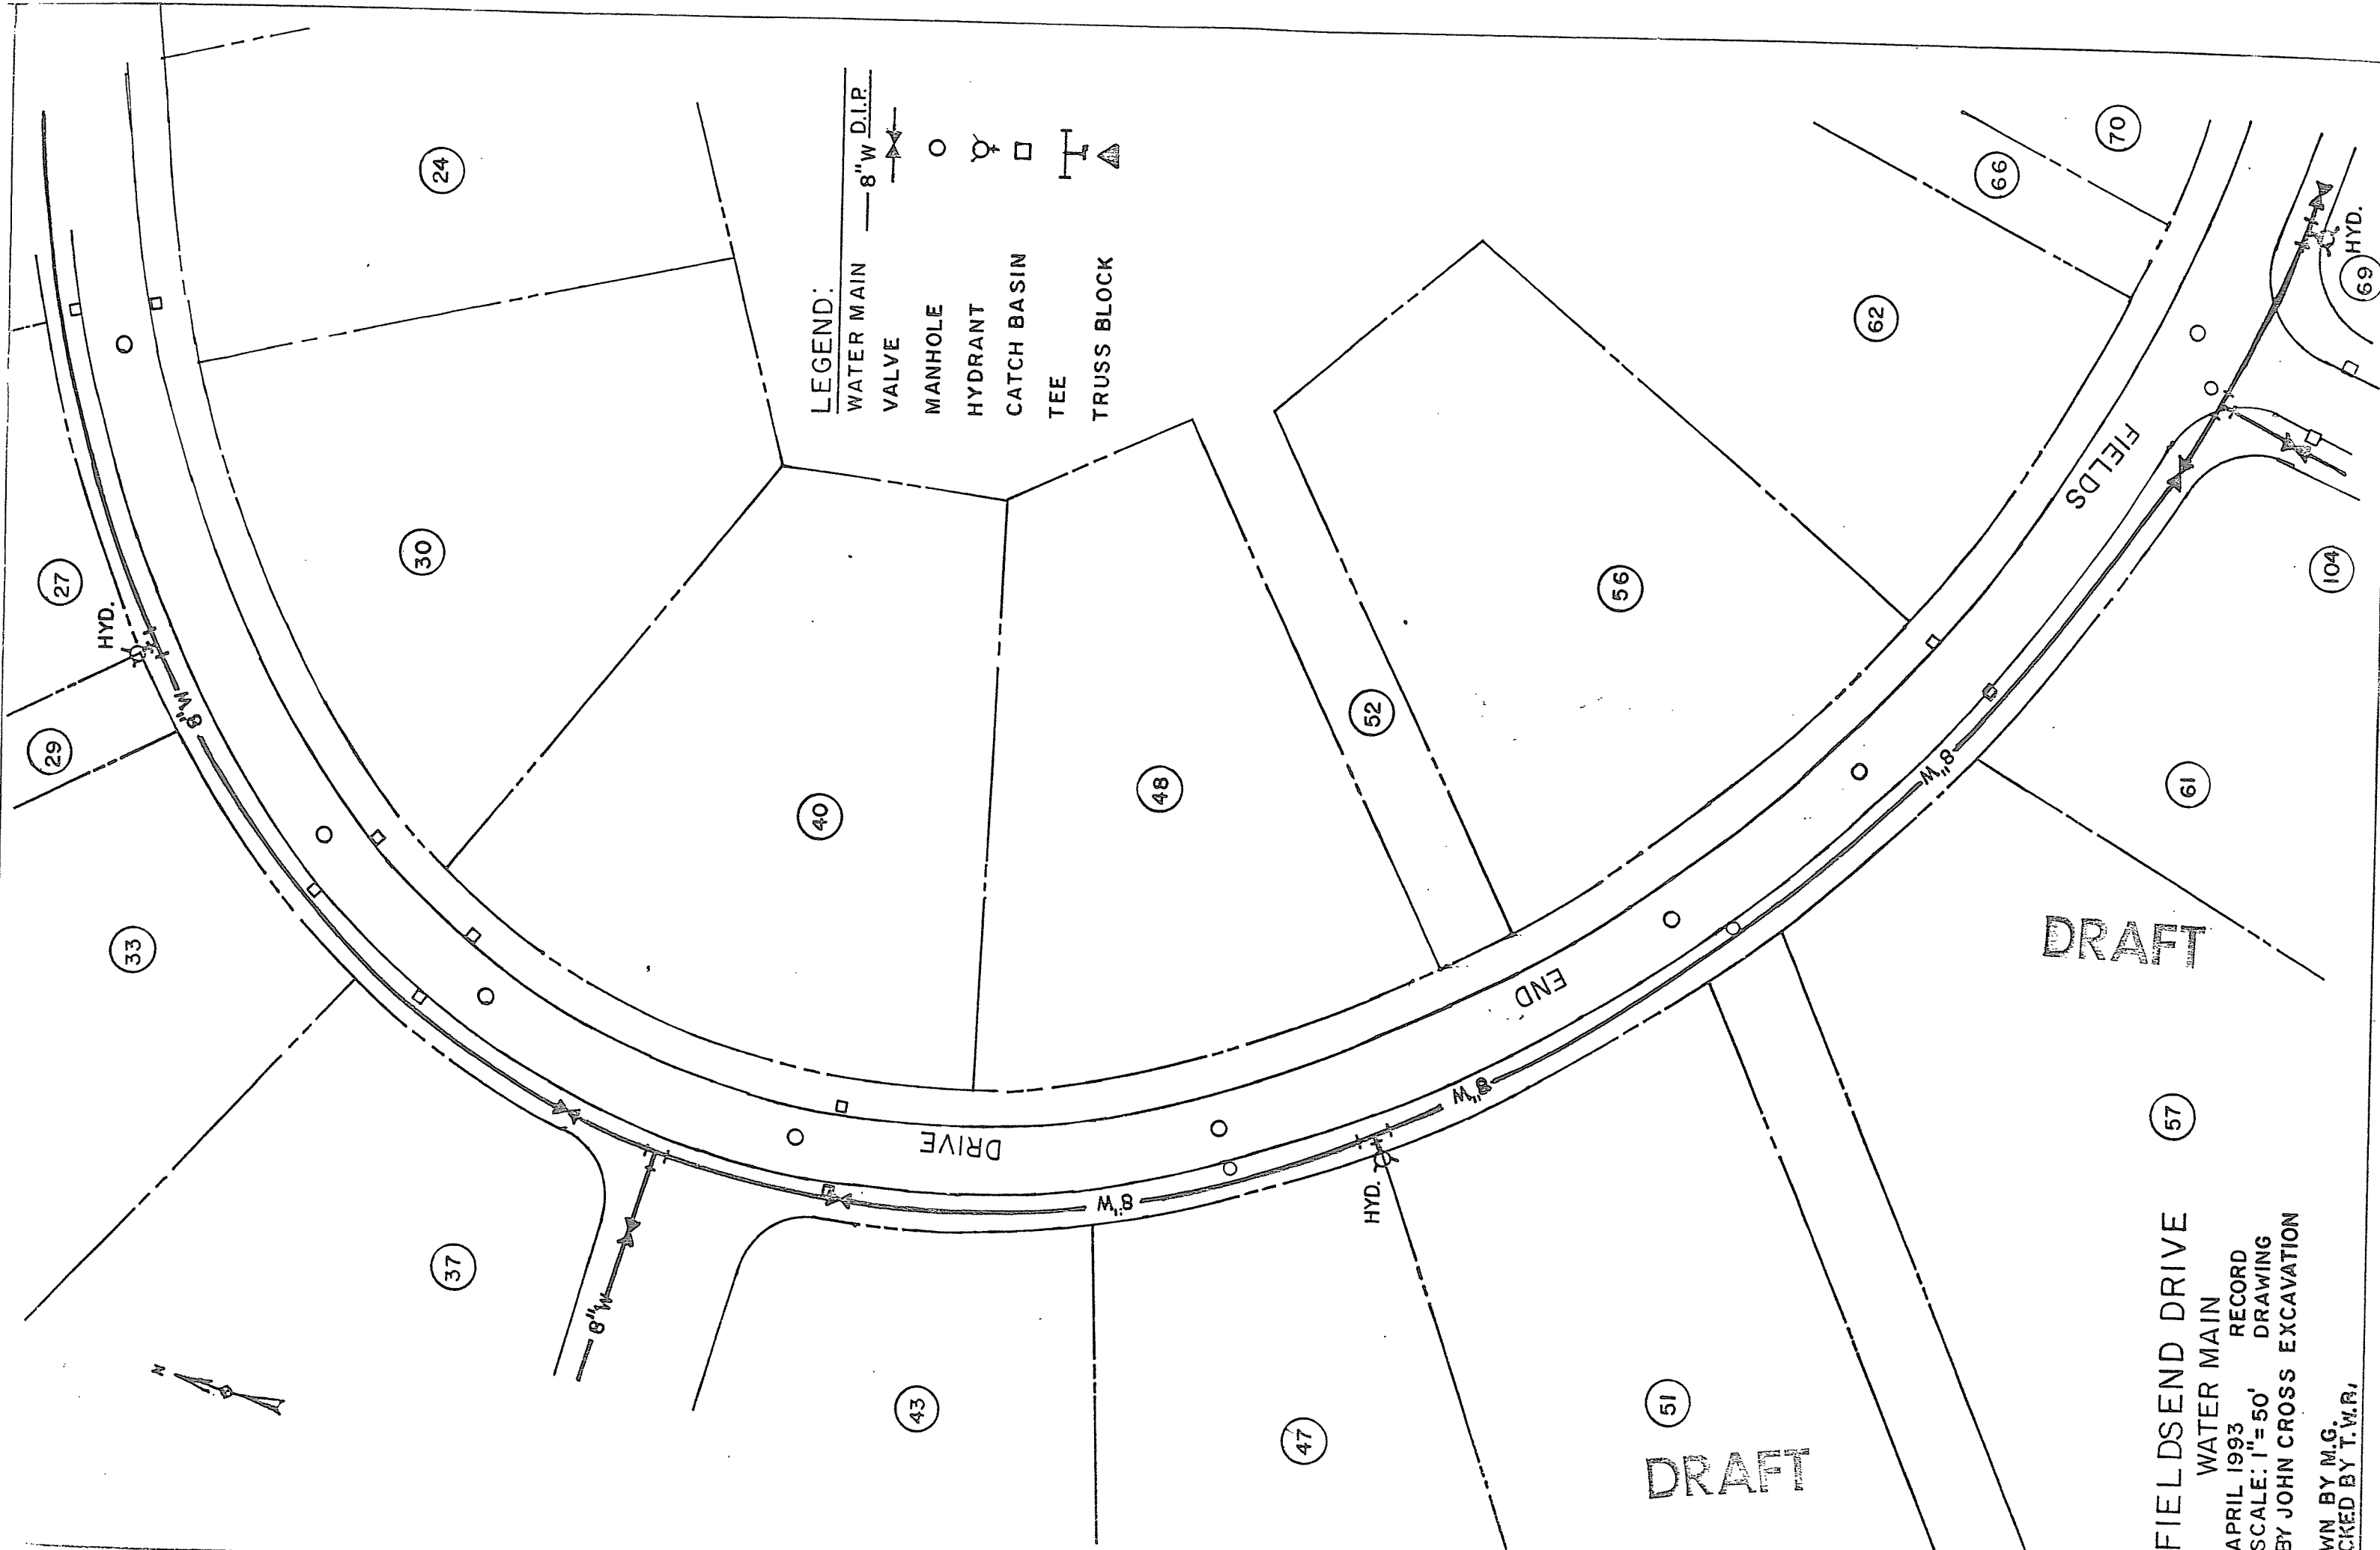

LEGEND:

WATER MAIN	8" W D.I.P.
VALVE	
MANHOLE	
HYDRANT	
CATCH BASIN	
TEE	
TRUSS BLOCK	

DRAFT

DRAFT

FIELDSEND DRIVE
WATER MAIN
APRIL 1993
SCALE: 1"=50'
BY JOHN CROSS EXCAVATION
DRAWN BY M.G.
CHECKED BY T.W.R.