


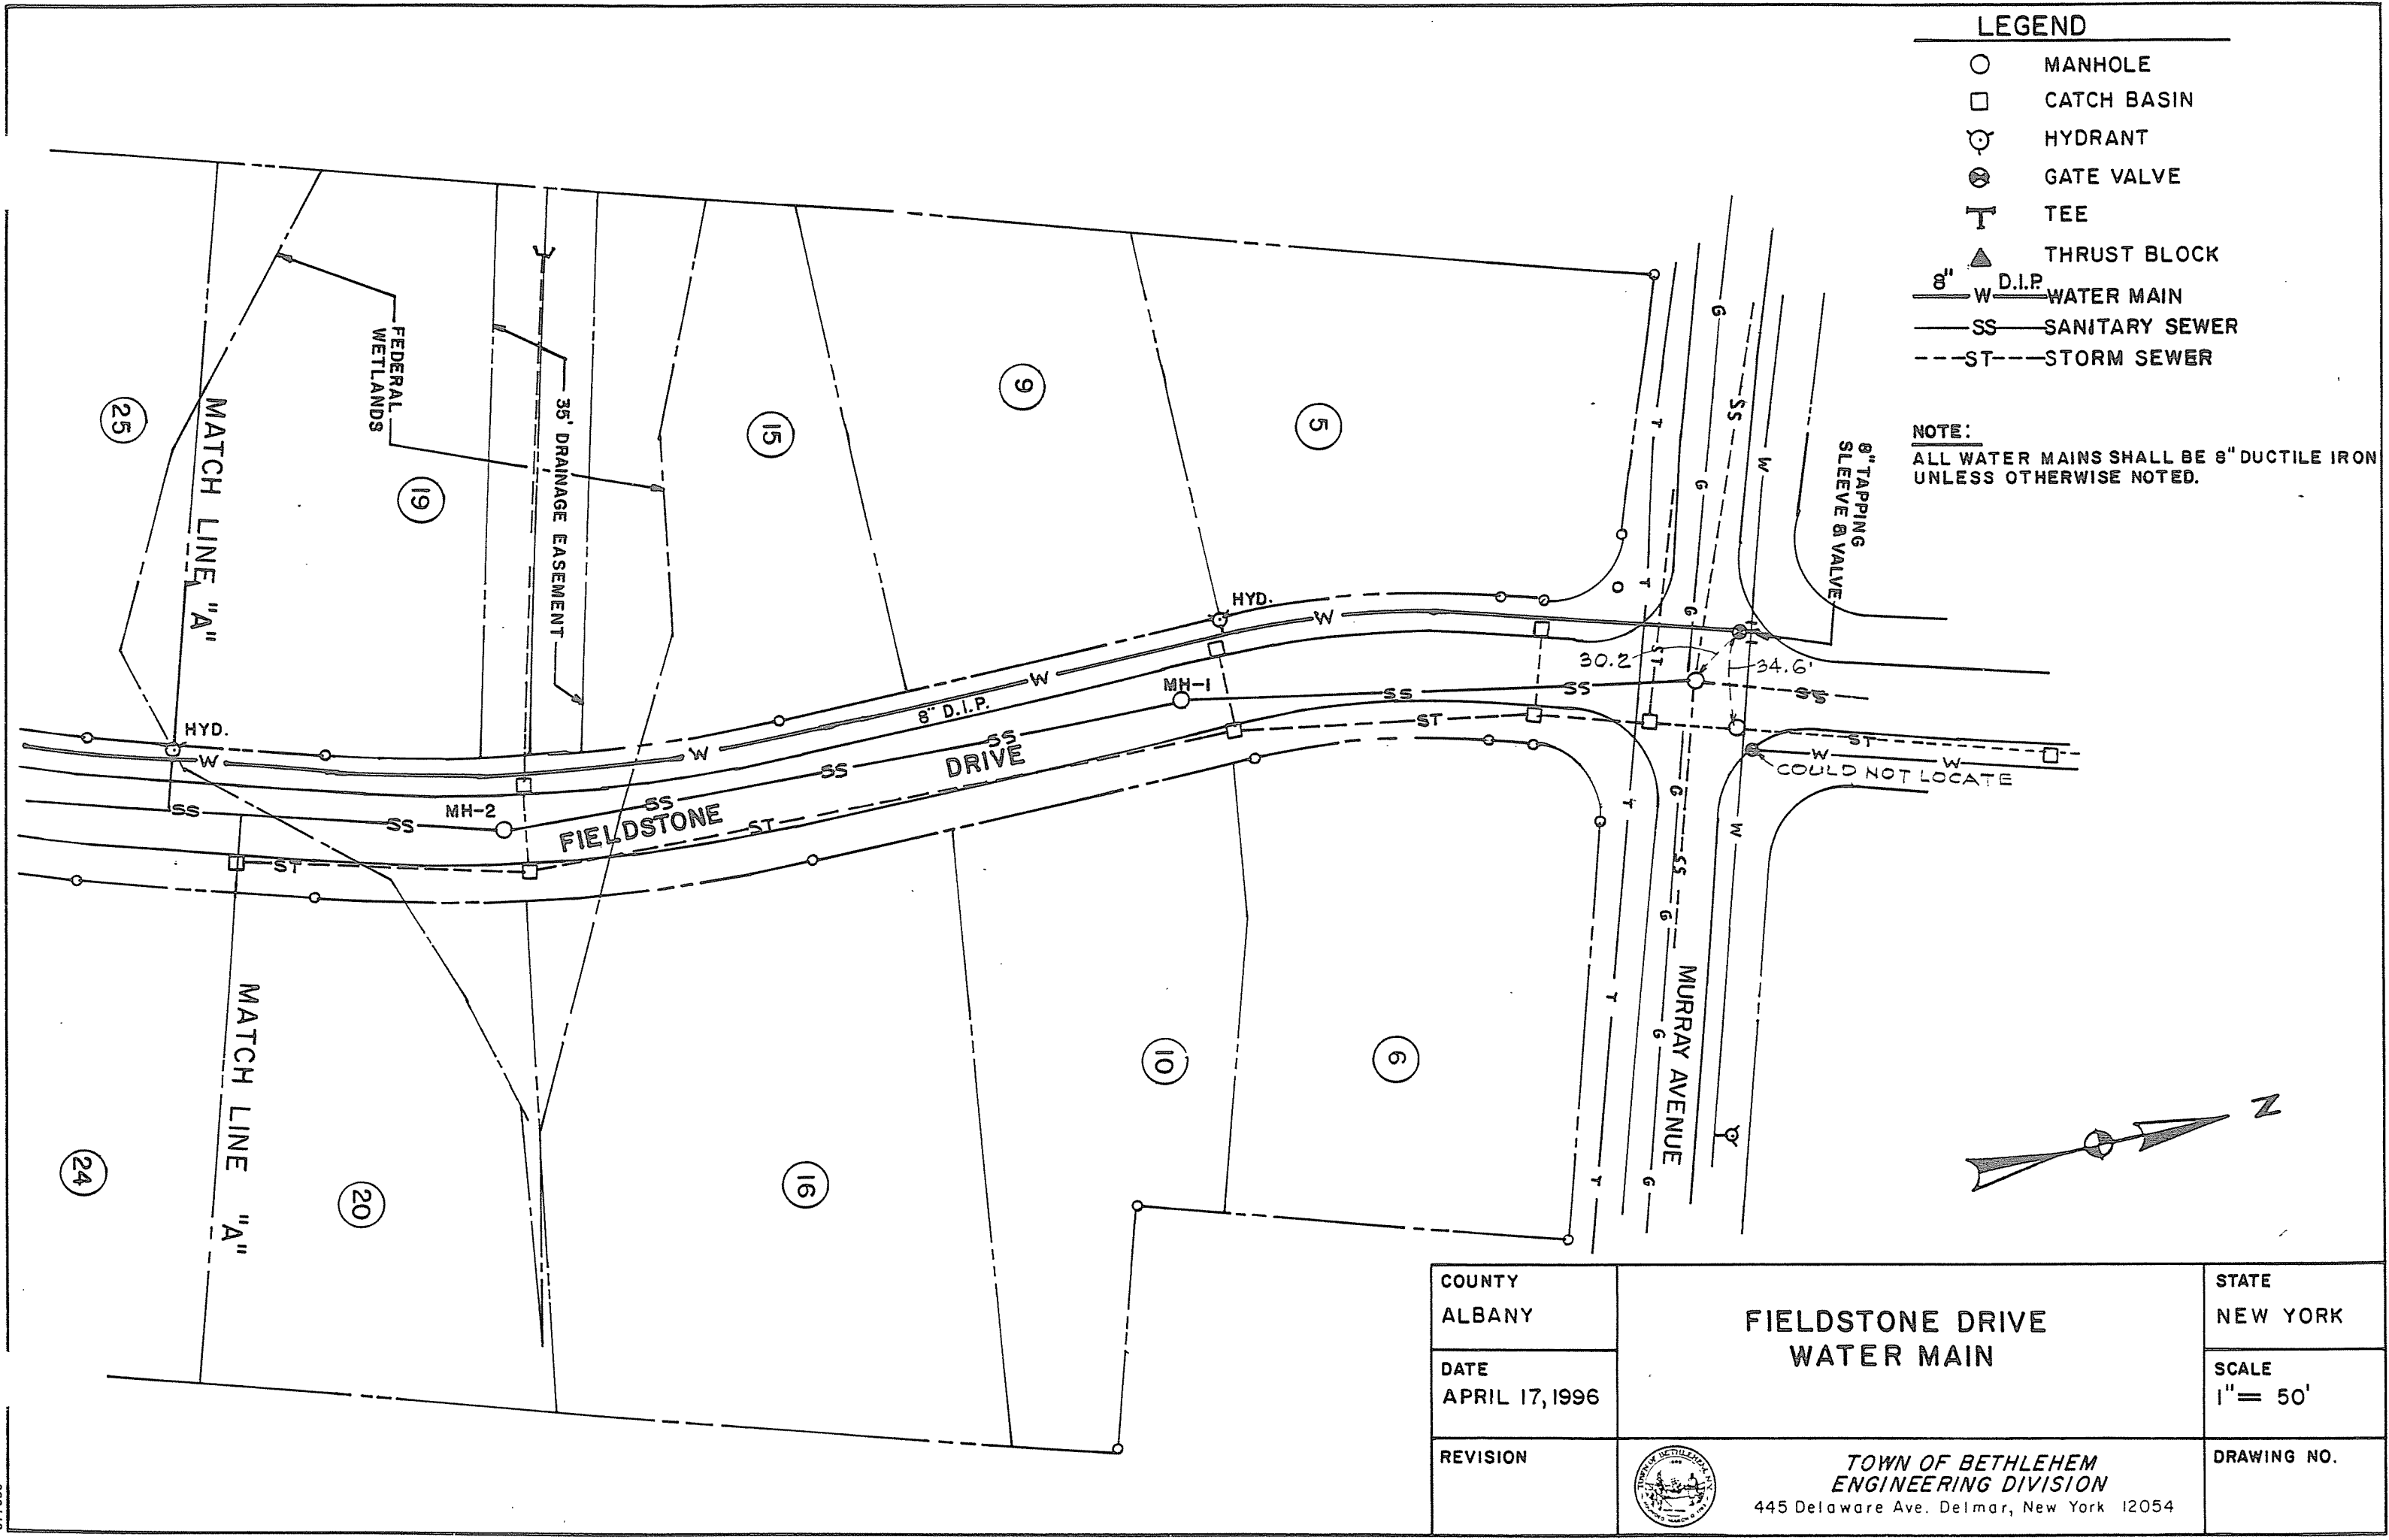

577650