


LEGEND

- MANHOLE
- CATCH BASIN
- ⊕ HYDRANT
- ⊗ GATE VALVE
- T TEE
- ▲ THRUST BLOCK
- 8" W D.I.P. WATER MAIN
- SS SANITARY SEWER
- ST STORM SEWER

NOTE:

ALL WATER MAINS SHALL BE 8" DUCTILE IRON UNLESS OTHERWISE NOTED.

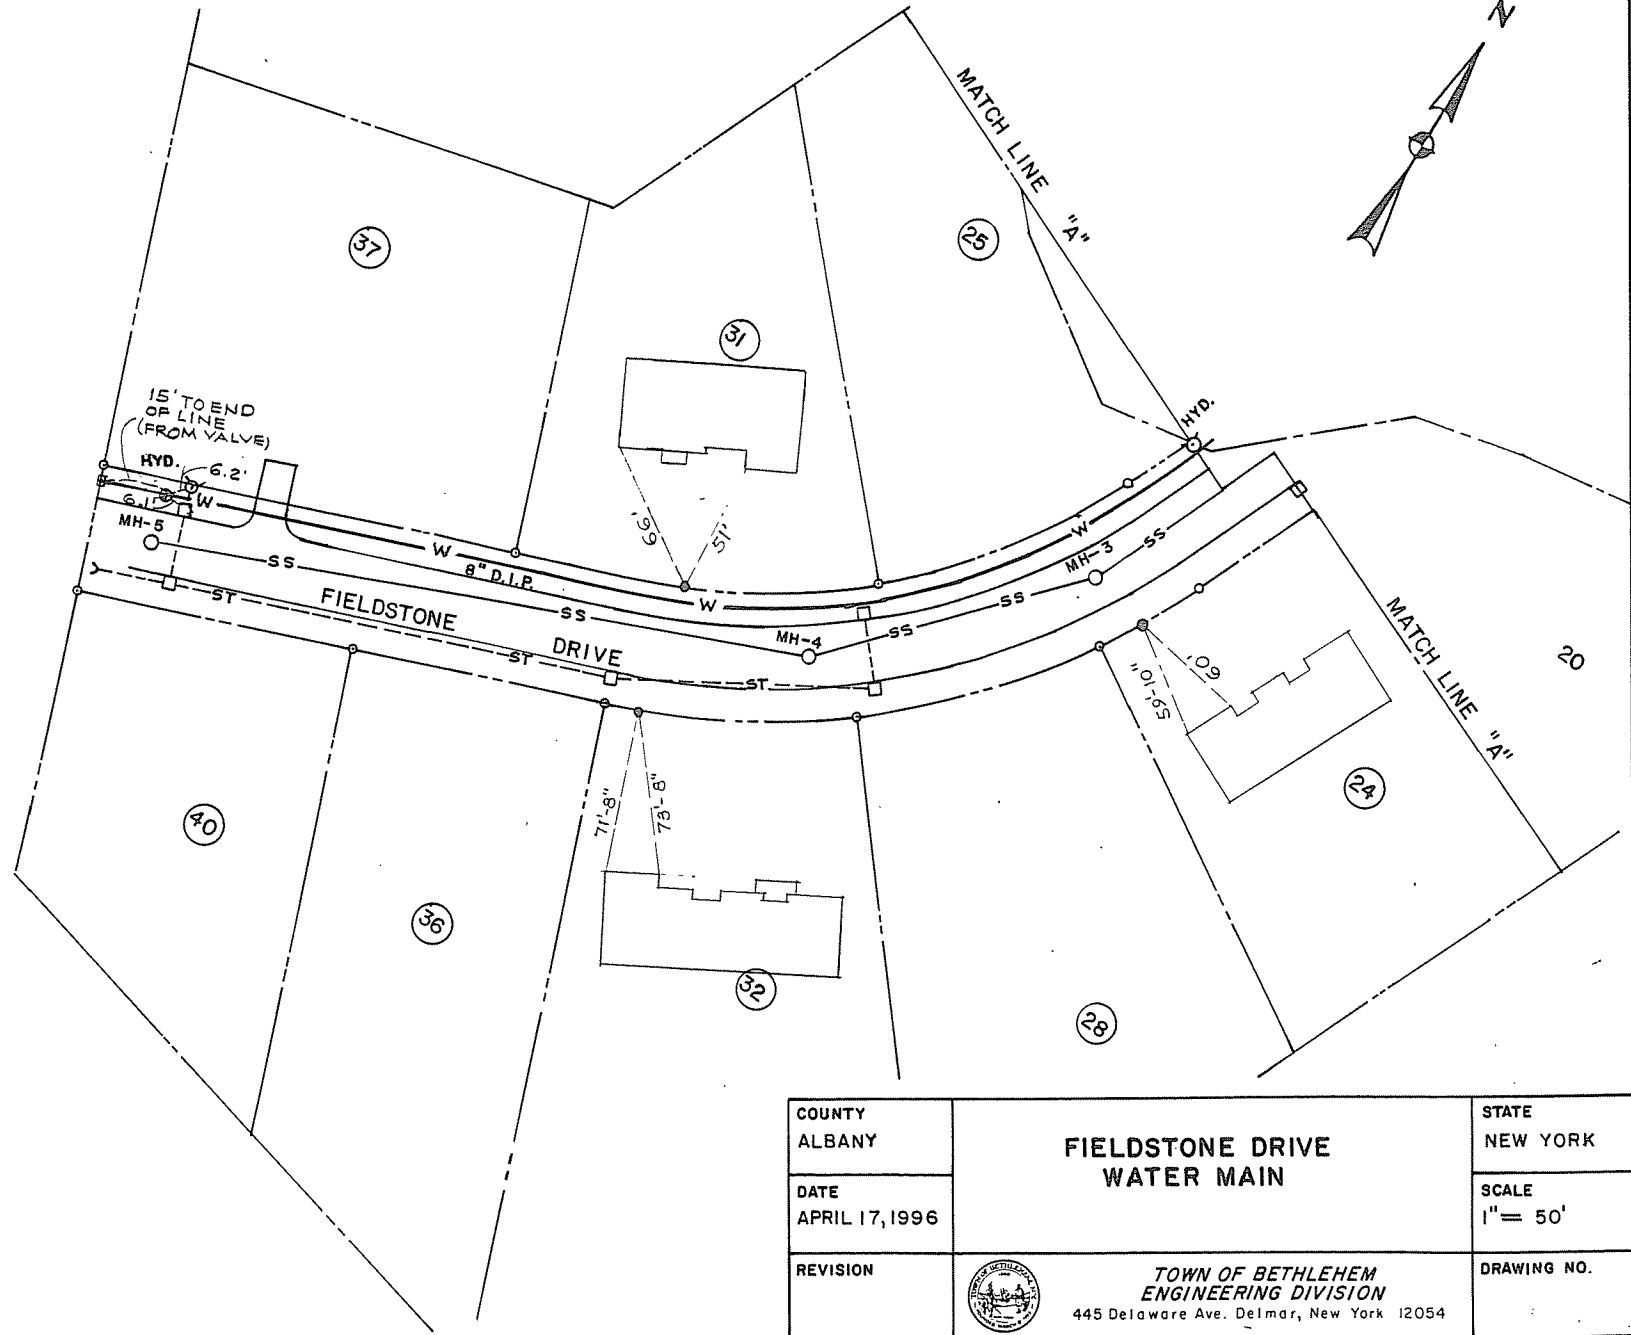

COUNTY ALBANY	FIELDSTONE DRIVE WATER MAIN	STATE NEW YORK
DATE APRIL 17, 1996		SCALE 1" = 50'
REVISION	 TOWN OF BETHLEHEM ENGINEERING DIVISION 445 Delaware Ave. Delmar, New York 12054	DRAWING NO.

FIELDSTONE CREEK