


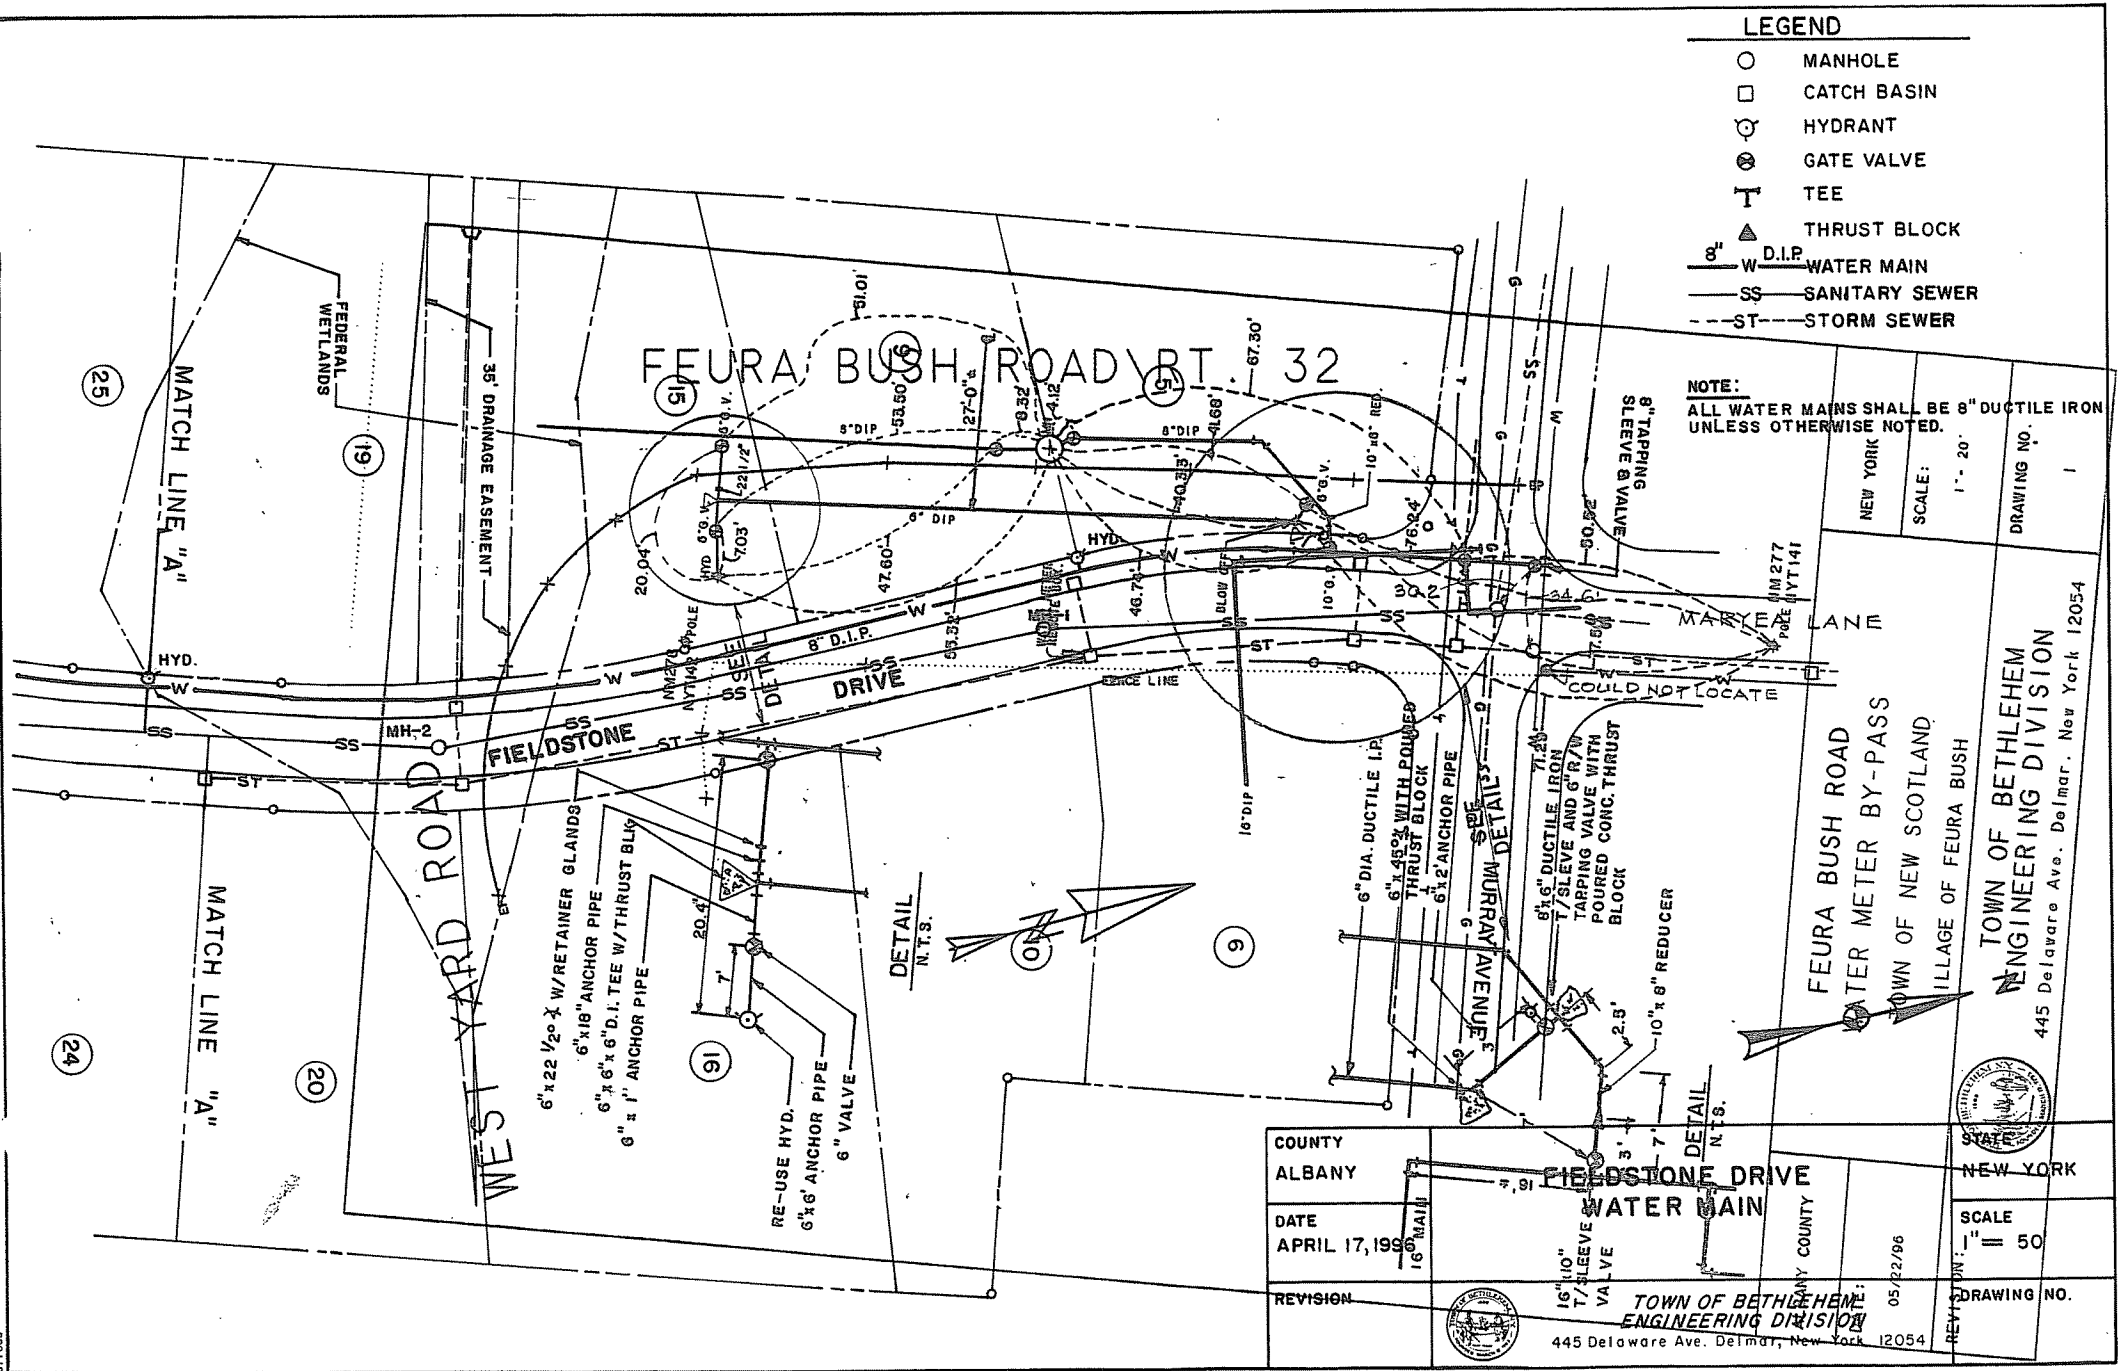

- LEGEND**
- MANHOLE
 - CATCH BASIN
 - ⊙ HYDRANT
 - ⊗ GATE VALVE
 - T TEE
 - ▲ THRUST BLOCK
 - 8" D.I.P. WATER MAIN
 - SS SANITARY SEWER
 - ST STORM SEWER

NOTE:
ALL WATER MAINS SHALL BE 8" DUCTILE IRON UNLESS OTHERWISE NOTED.

NEW YORK
SCALE: 1" = 20'
DRAWING NO. 1

FEURA BUSH ROAD
WATER METER BY-PASS
TOWN OF NEW SCOTLAND
VILLAGE OF FEURA BUSH
TOWN OF BETHLEHEM
ENGINEERING DIVISION
445 Delaware Ave. Delmar, New York 12054



COUNTY ALBANY	NEW YORK
DATE APRIL 17, 1996	SCALE 1" = 50'
REVISION	DRAWING NO.
TOWN OF BETHLEHEM ENGINEERING DIVISION 445 Delaware Ave. Delmar, New York 12054	

