


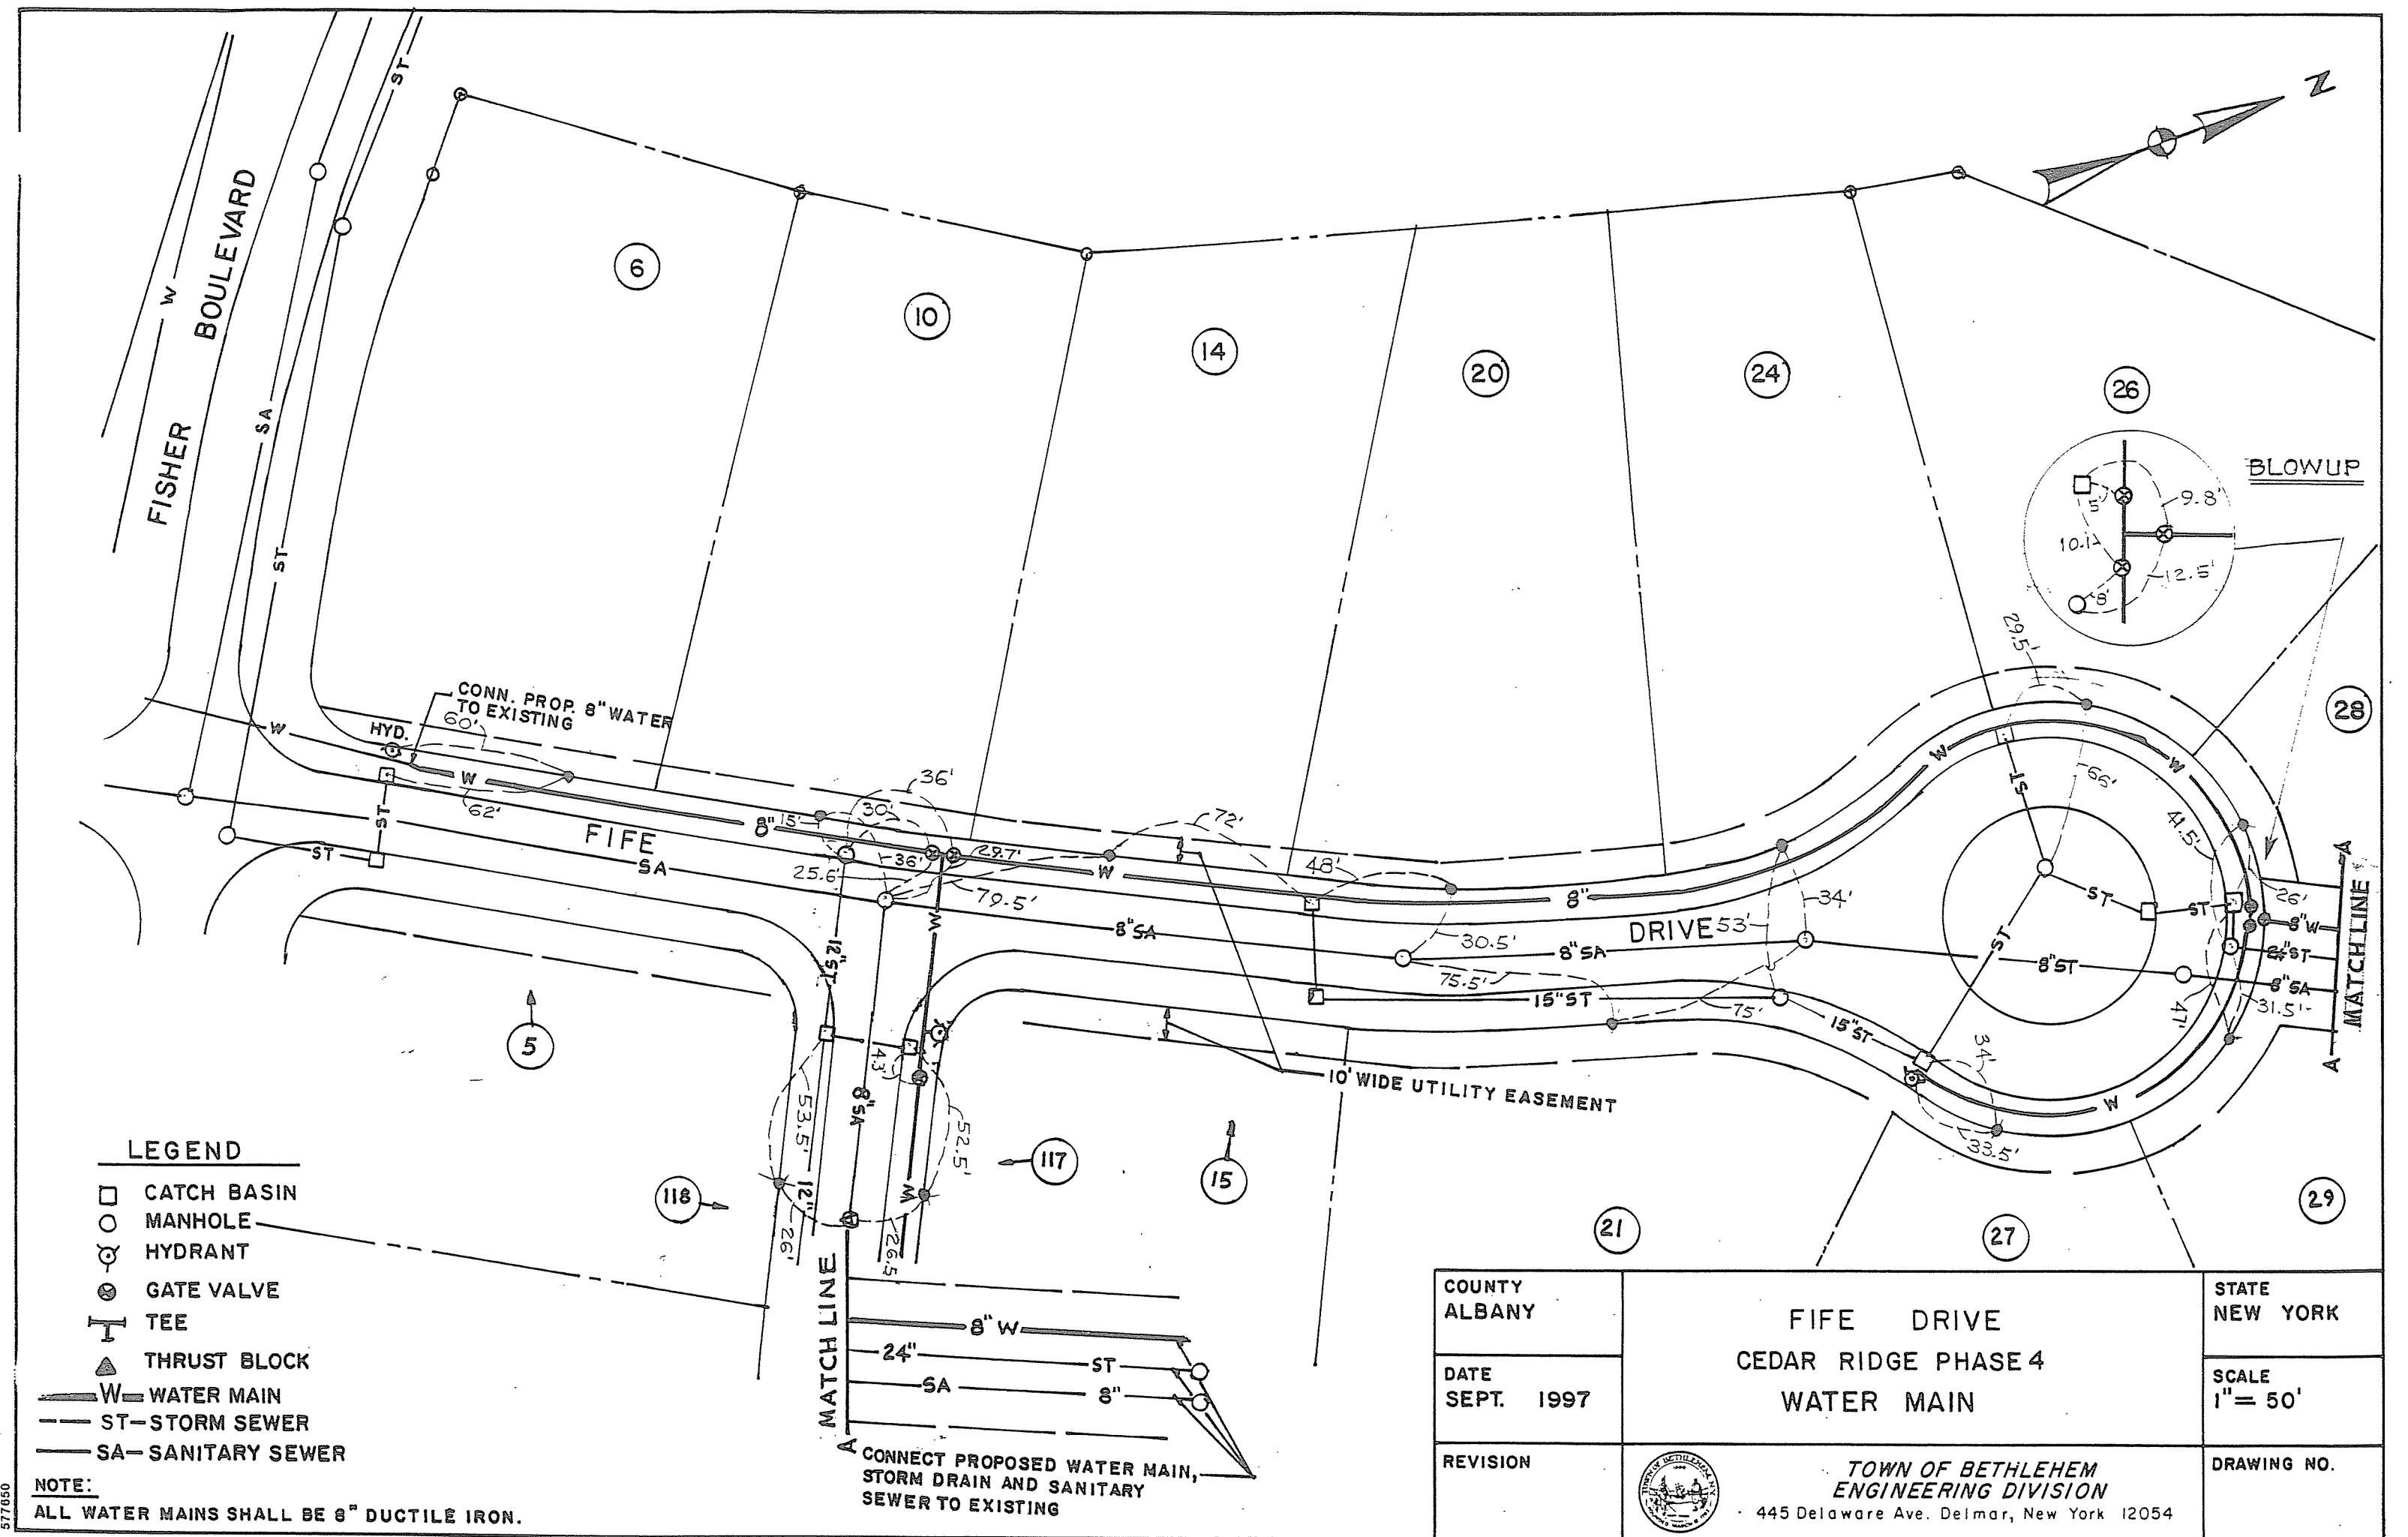

|                    |                                                                                       |                   |
|--------------------|---------------------------------------------------------------------------------------|-------------------|
| COUNTY<br>ALBANY   | FIFE DRIVE<br>CEDAR RIDGE PHASE 4<br>WATER MAIN                                       | STATE<br>NEW YORK |
| DATE<br>SEPT. 1997 |                                                                                       | SCALE<br>1" = 50' |
| REVISION           | TOWN OF BETHLEHEM<br>ENGINEERING DIVISION<br>445 Delaware Ave. Delmar, New York 12054 | DRAWING NO.       |

577050