

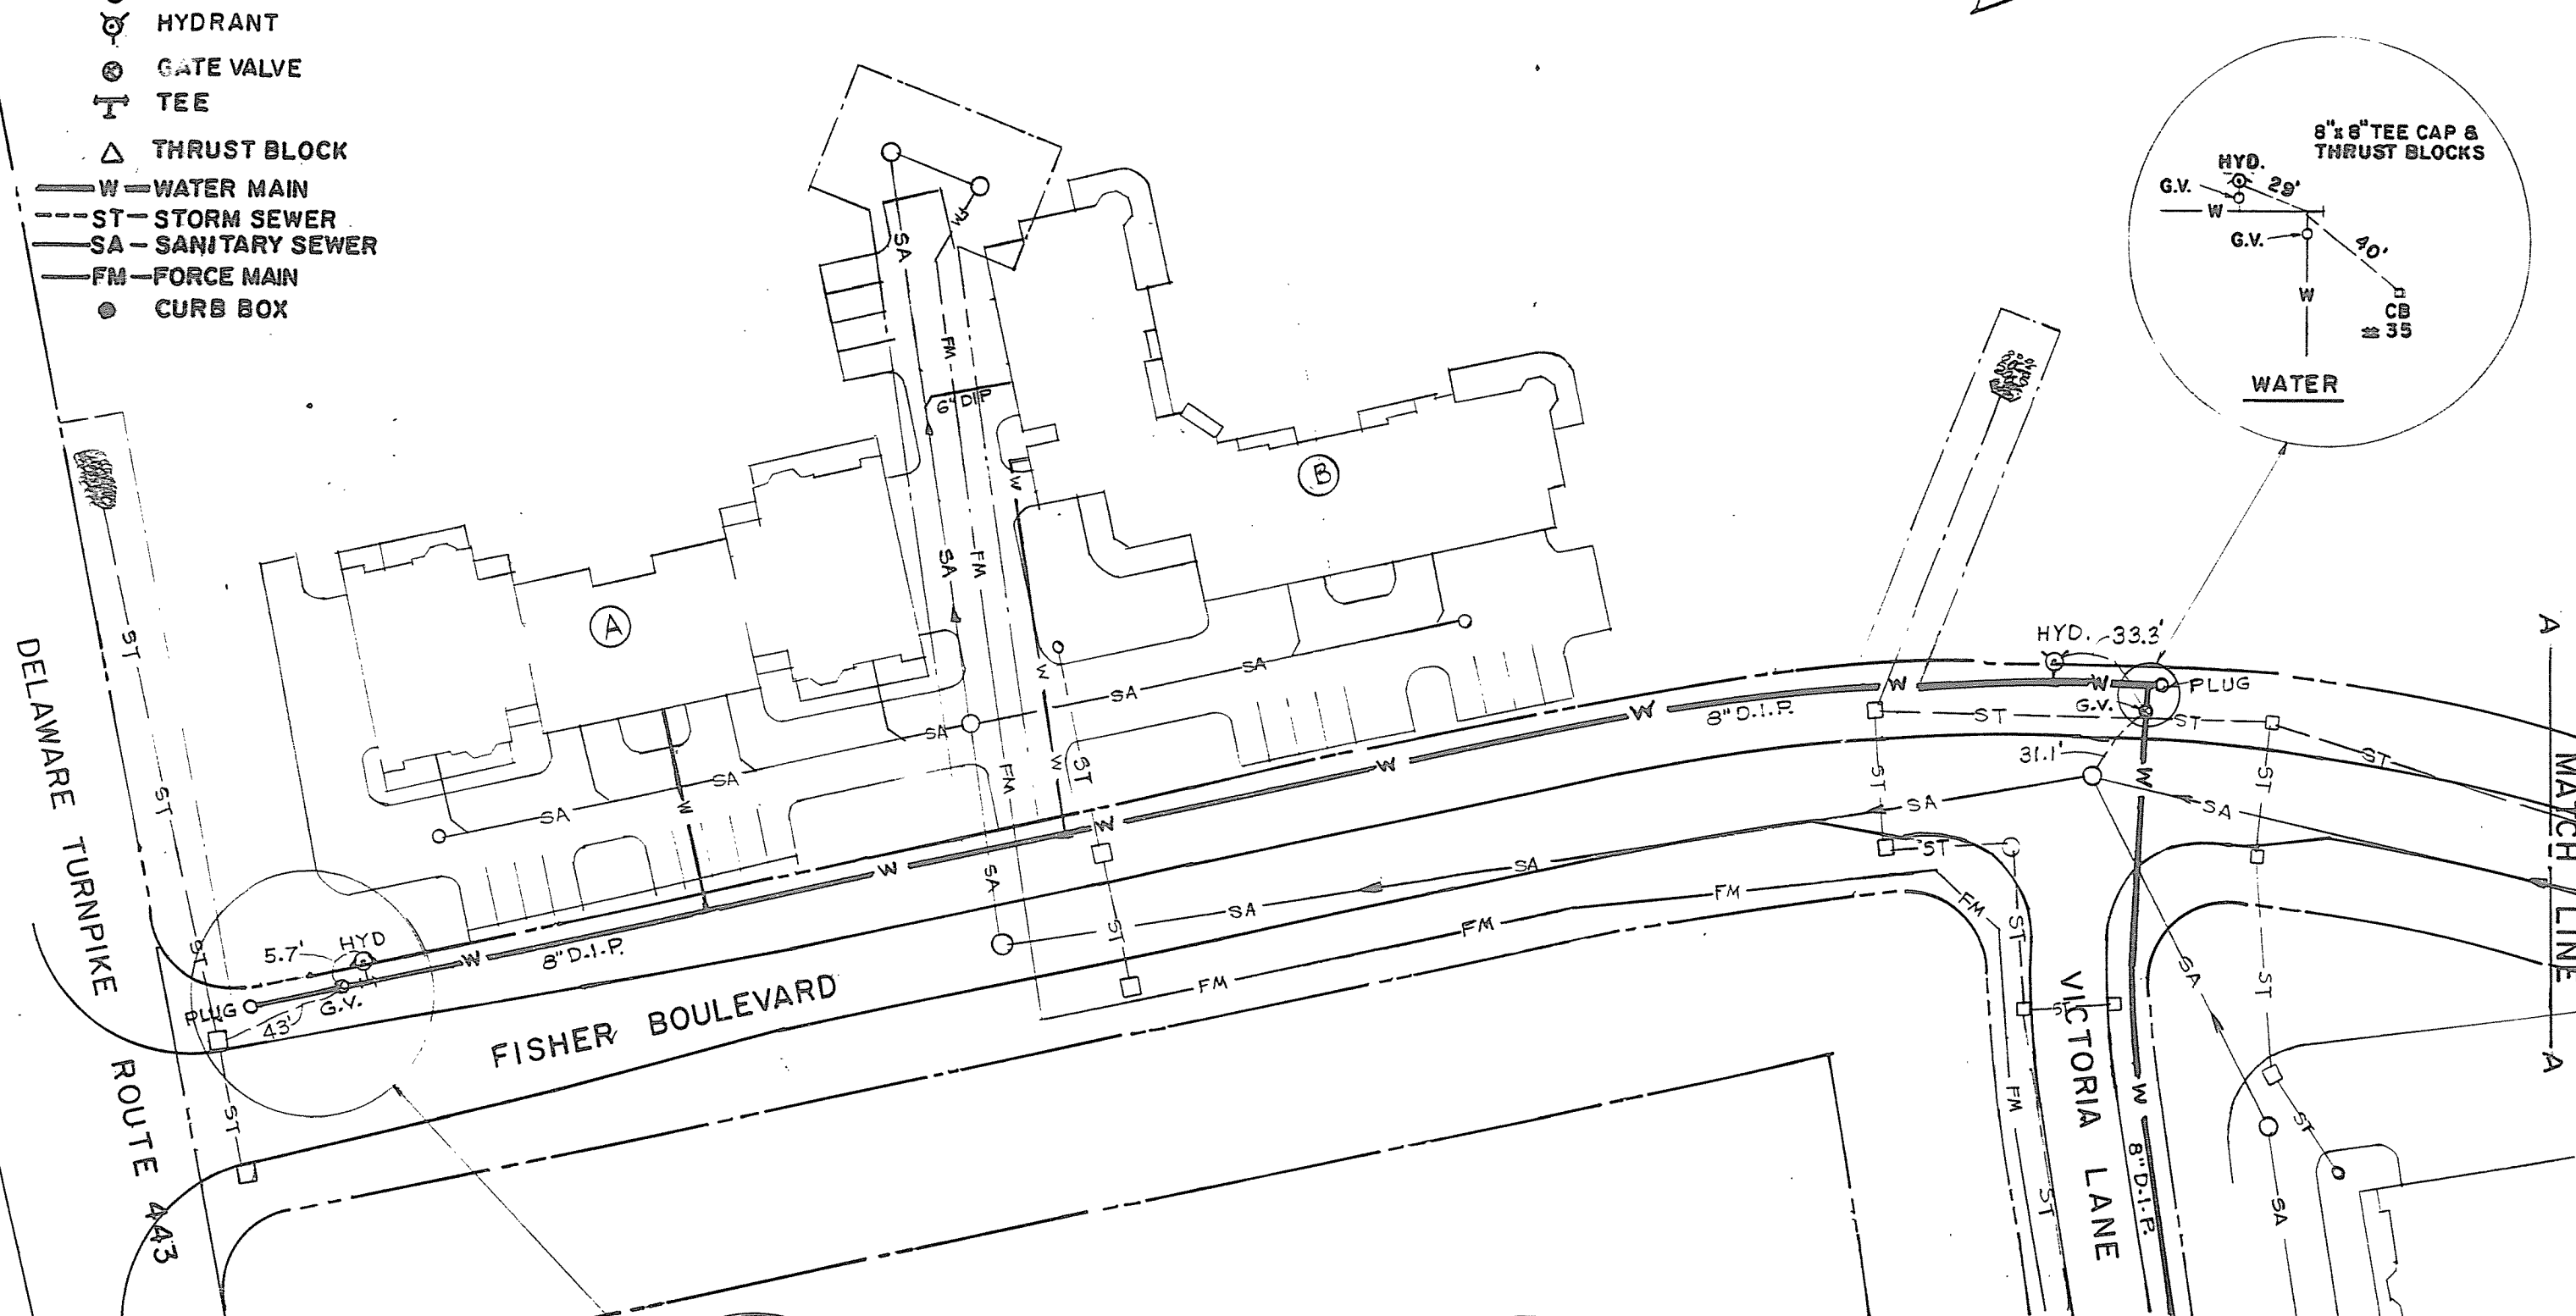
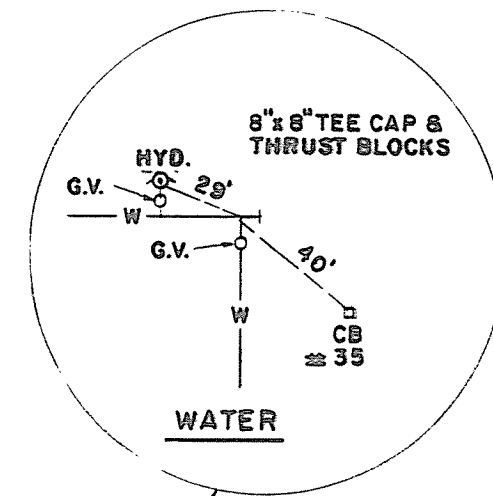


LEGEND

- CATCH BASIN
- MANHOLE
- ⊗ HYDRANT
- ⊙ GATE VALVE
- ⊥ TEE
- △ THRUST BLOCK
- W — WATER MAIN
- - - ST — STORM SEWER
- SA — SANITARY SEWER
- FM — FORCE MAIN
- CURB BOX

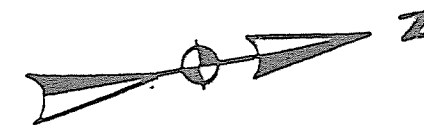

COUNTY ALBANY	FISHER BLVD. DELAMAR VILLAGE WATER MAIN LOCATIONS	STATE NEW YORK
DATE APRIL 10, 2000		SCALE 1" = 50'
REVISION	 TOWN OF BETHLEHEM ENGINEERING DIVISION 445 Delaware Ave. Delmar, New York 12054	DRAWING NO.

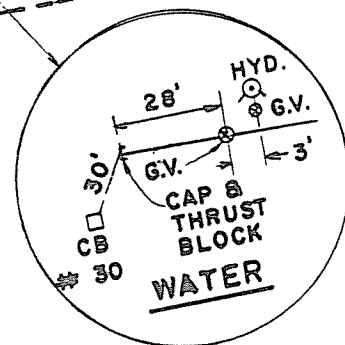

DELAMAR VILLAGE