


Note:
Waiting for info
from John.

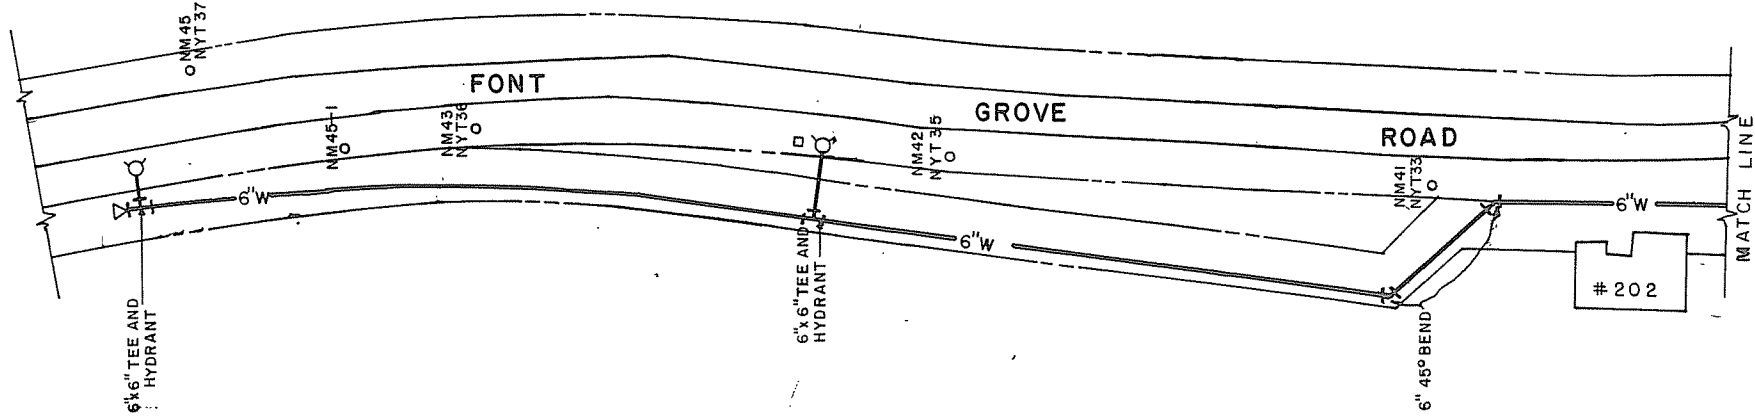

Preliminary

FONT GROVE ROAD
WATER MAIN EXT.

INSTALLED BY T.O.B. WATER DEPT.

SCALE: 1"=50'

DATE: JUNE 1992

M.G.