

FONT GROVE ROAD

WATER DISTRICT NO. 1

TOWN OF BETHLEHEM


RECORD OF INSTALLATION

TOWN OF BETHLEHEM ENGINEERING

DEPARTMENT

SCALE: 1" = 50' DECEMBER, 1982

DWN. BY: PDH

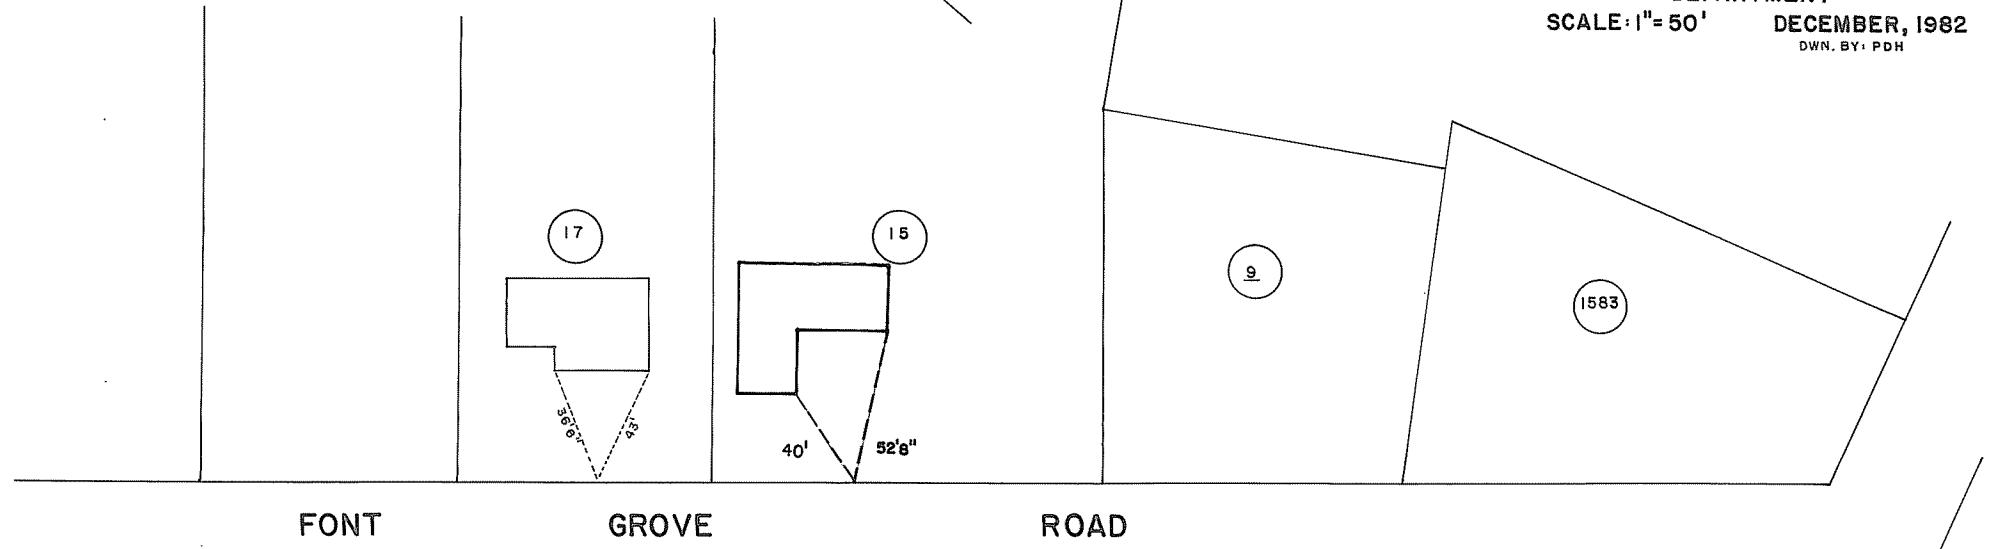

FONT

GROVE

ROAD

ROAD

SCOTLAND

N E W

1599