


Note:
Waiting for info
from John.

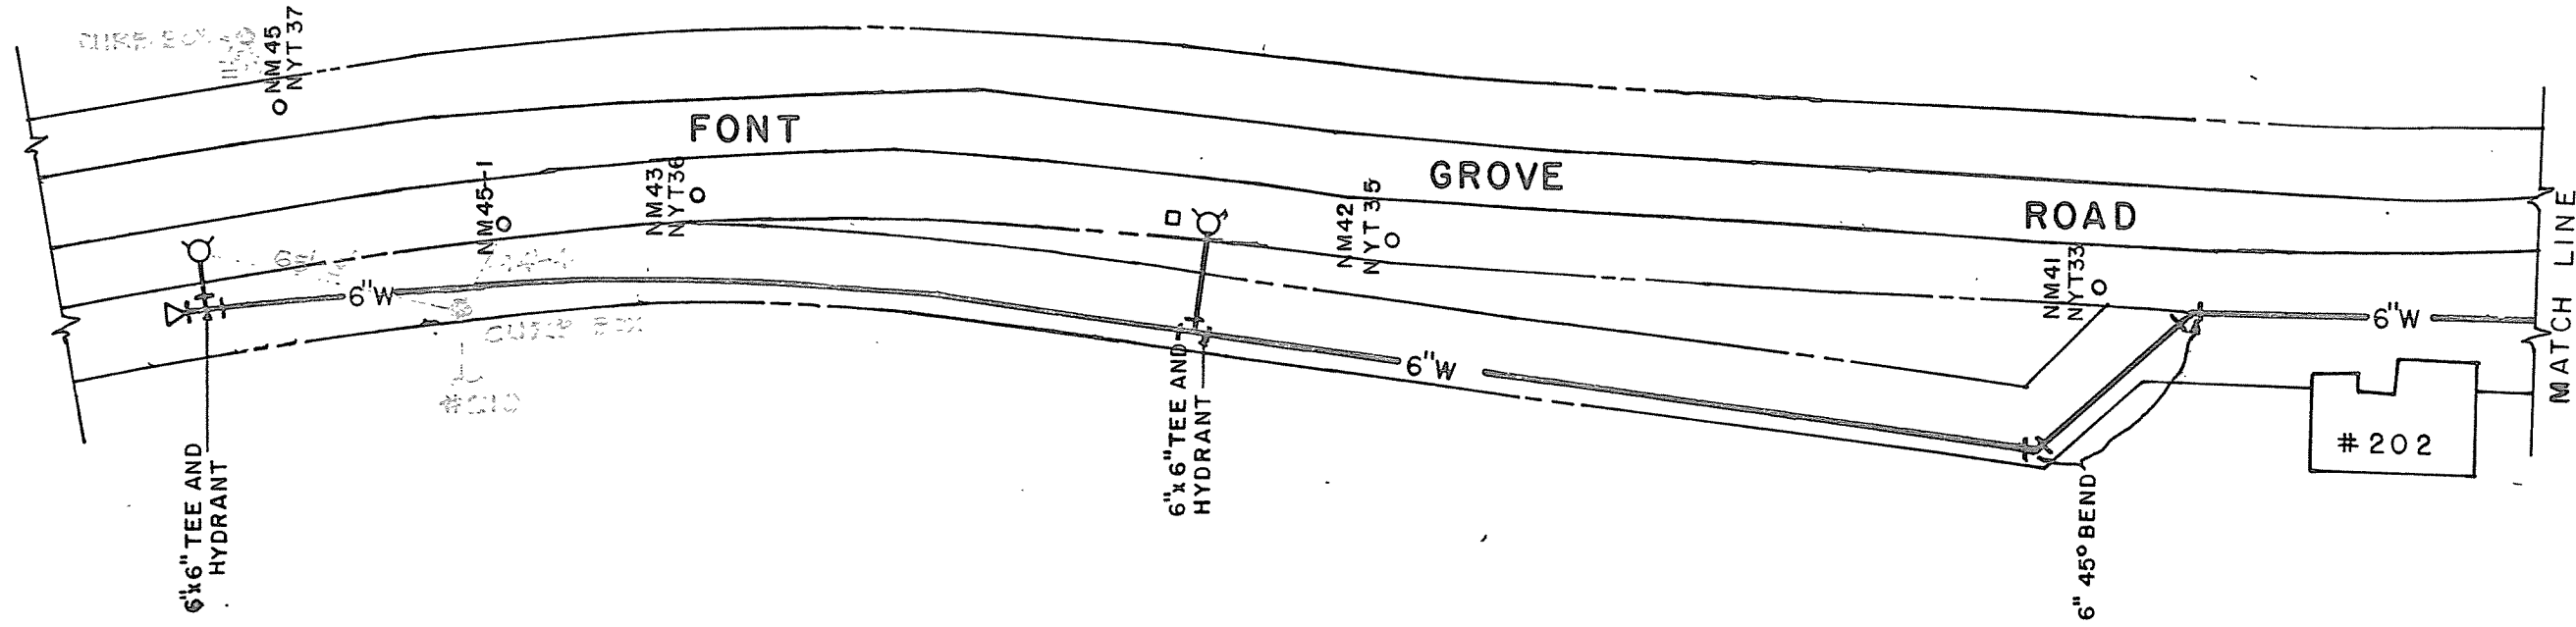

Preliminary

FONT GROVE ROAD

WATER MAIN EXT.

INSTALLED BY T.O.B. WATER DEPT.

SCALE: 1" = 50'

DATE: JUNE 1992