


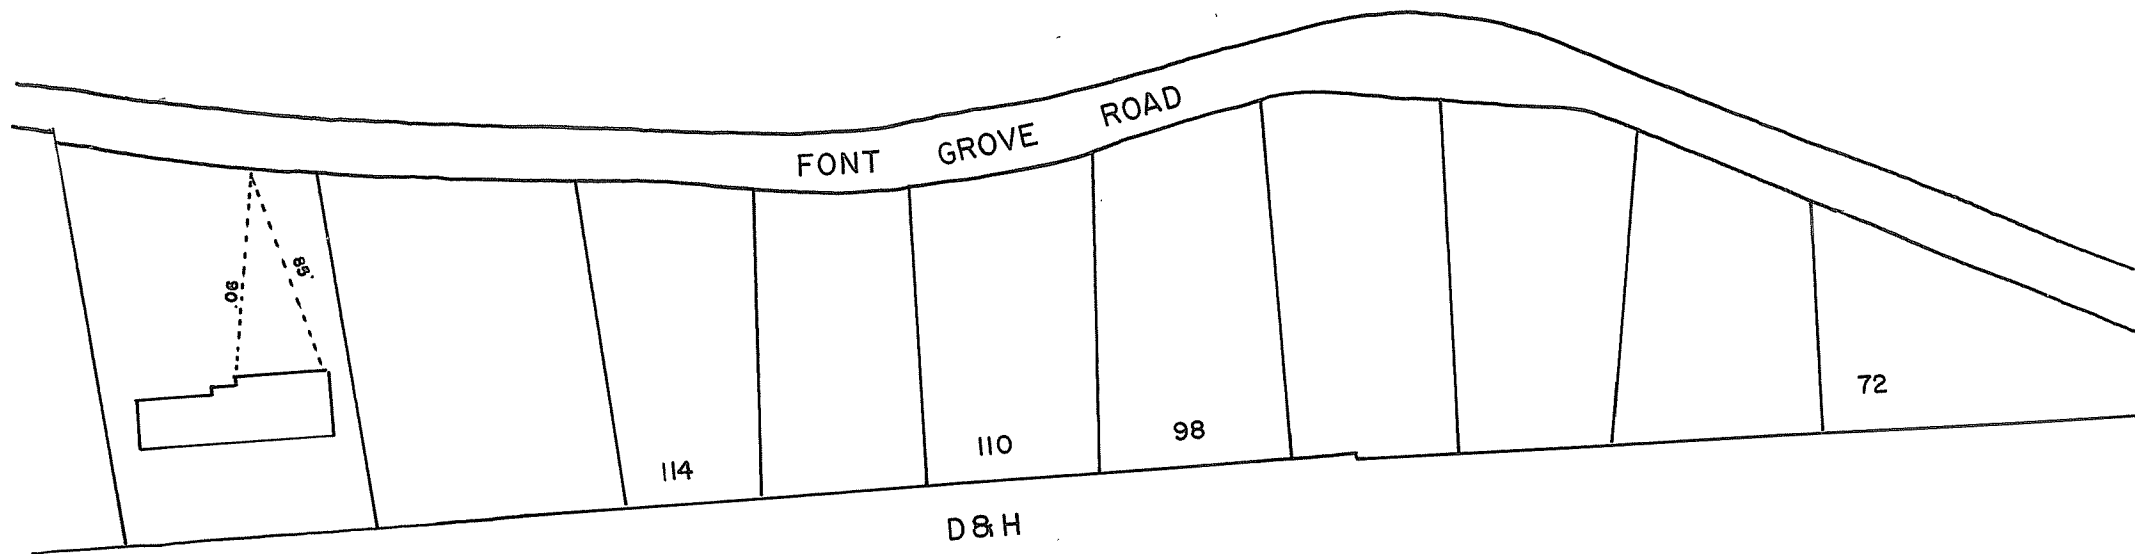

FONT GROVE ROAD