


FONT GROVE ROAD
WATER DISTRICT NO. 1
TOWN OF BETHLEHEM

RECORD OF INSTALLATION
TOWN OF BETHLEHEM ENGINEERING
DEPARTMENT

SCALE: 1"=50' DECEMBER, 1982
DWN. BY: PDH

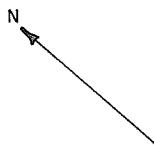

81

FONT GROVE ROAD

72