


Notes:
waiting for info
from John.

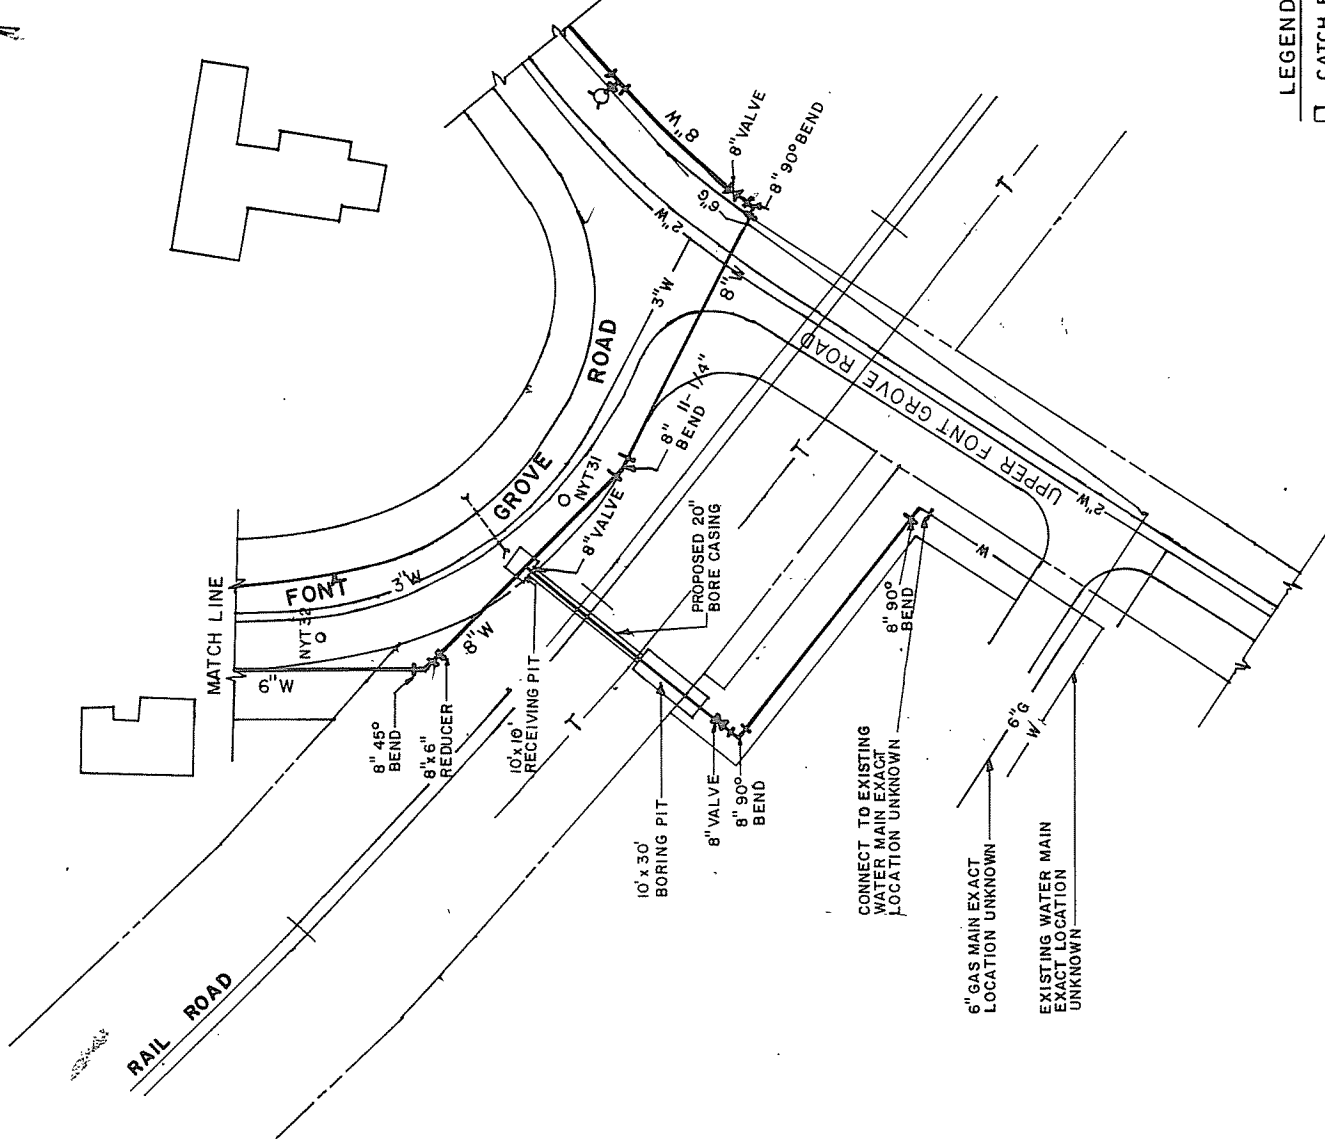

LEGEND

- CATCH BASIN
- MANHOLE
- ⊙ HYDRANT
- ⌵ GATE VALVE
- ⊕ TEE
- ▲ THRUST BLOCK
- W— WATER MAIN

Preliminary

FONT GROVE ROAD WATER MAIN EXT.

INSTALLED BY T.O.B. WATER DEPT.

SCALE: 1" = 50'

DATE: JUNE 1992.