

**FREDRICK PLACE**


WATER DISTRICT NO.1  
TOWN OF BETHLEHEM

**RECORD OF INSTALLATION**

TOWN OF BETHLEHEM ENGINEERING  
DEPARTMENT


SCALE: 1" = 50' NOVEMBER, 1982

DWN.BY: PDH

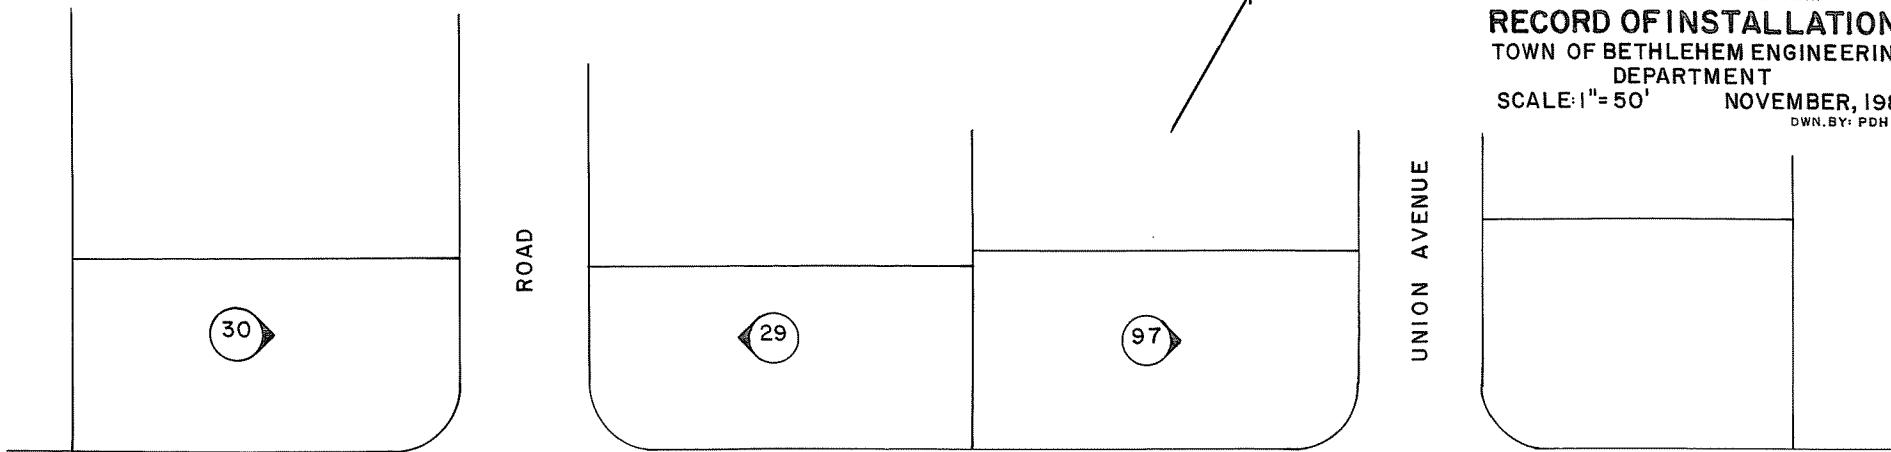

**FREDRICK**

**PLACE**

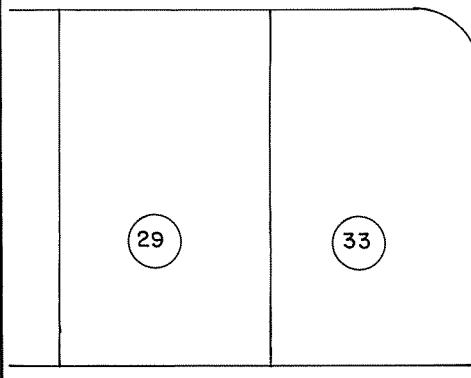

**ELWOOD**

