


N

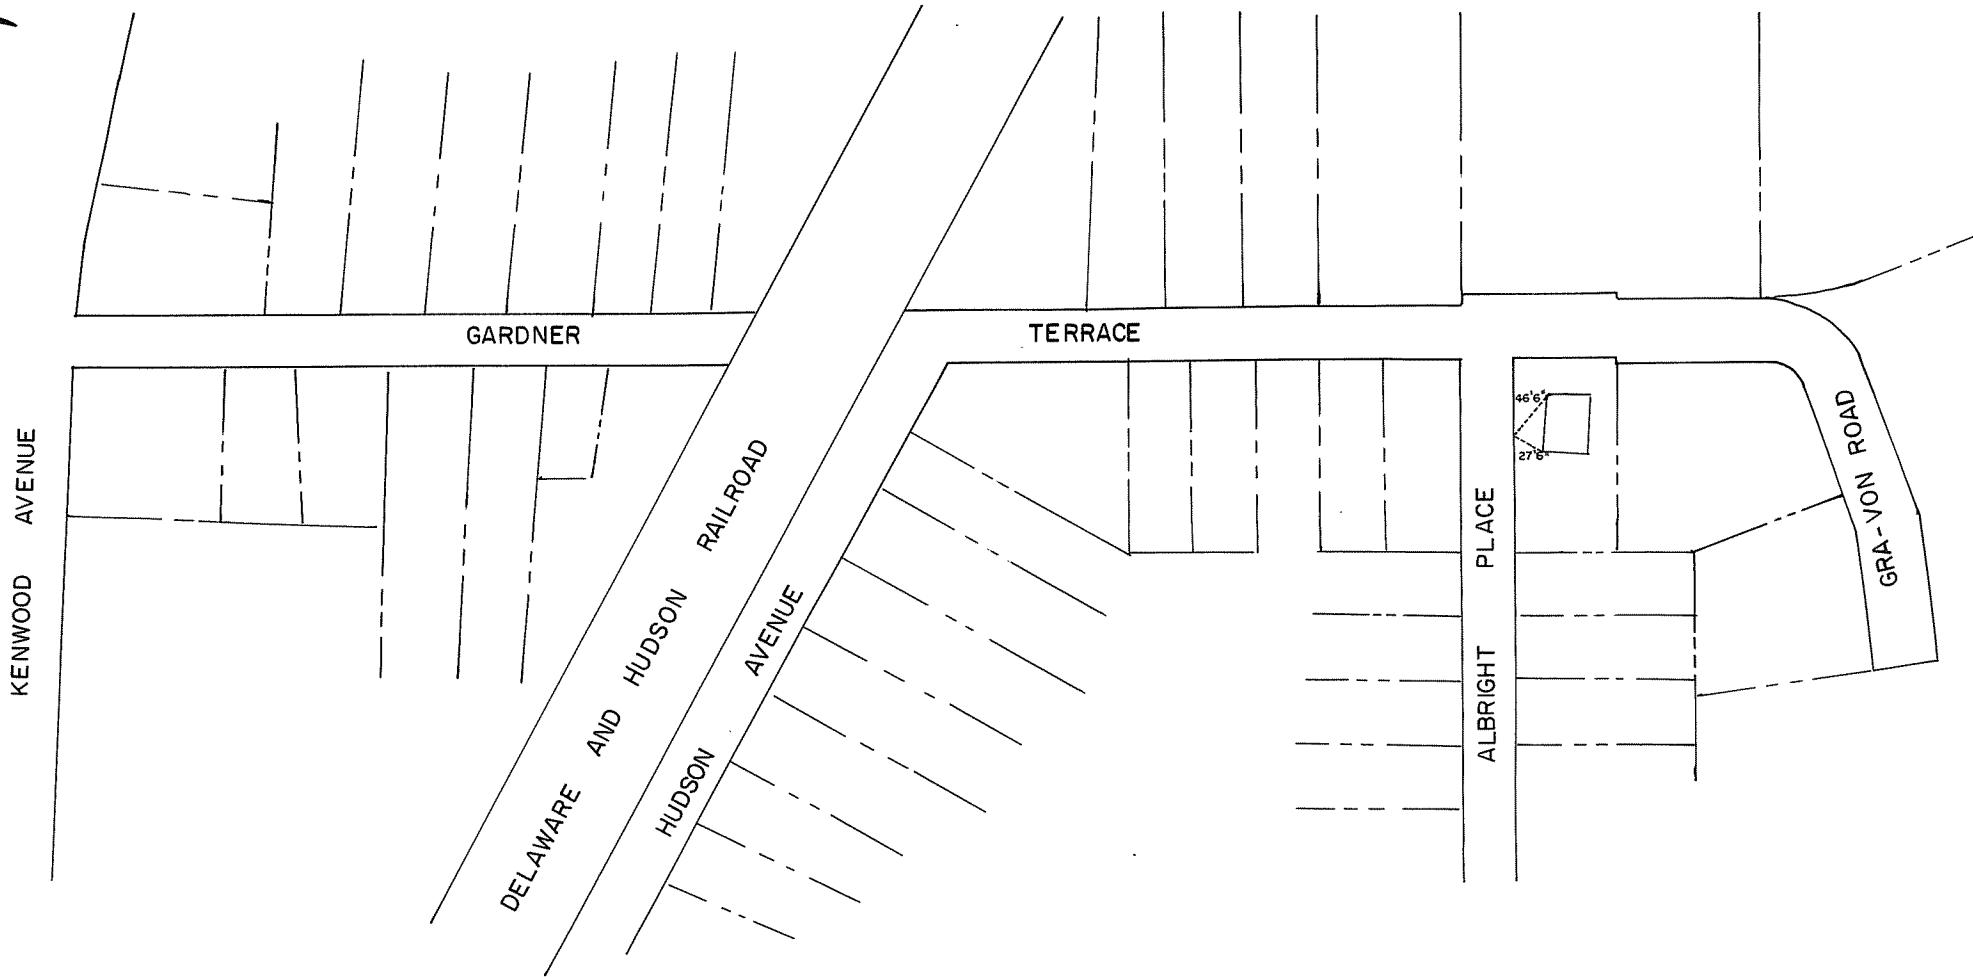

GARDNER TERRACE
WATER DISTRICT NO. 1
TOWN OF BETHLEHEM
RECORD OF INSTALLATION
SCALE 1" = 100' JULY 1986