

GARDNER TERRACE

WATER DISTRICT NO. 1

TOWN OF BETHLEHEM


RECORD OF INSTALLATION

TOWN OF BETHLEHEM ENGINEERING

DEPARTMENT

SCALE: 1"=50' MARCH, 1982

DWN.BY: PDH

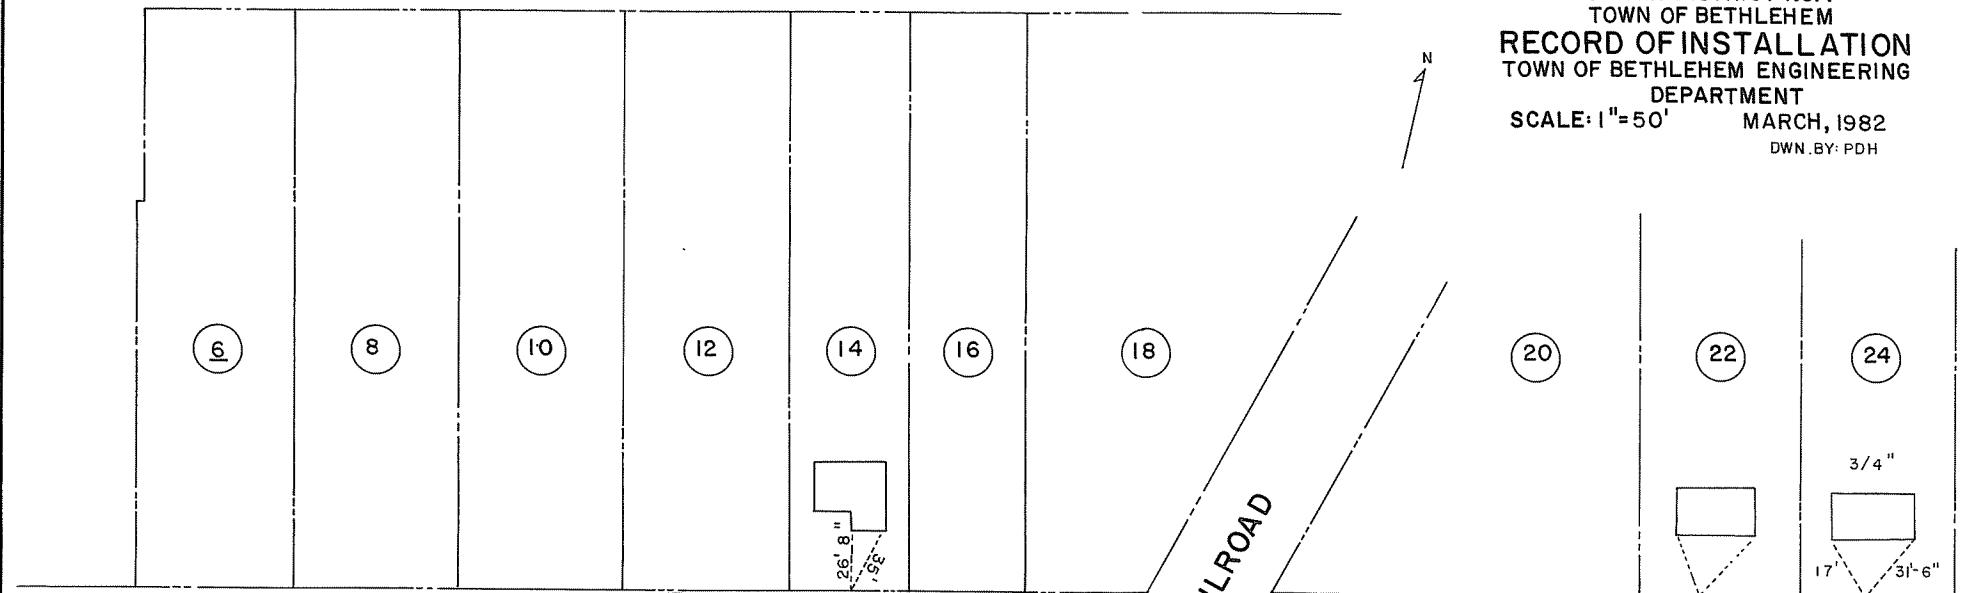

GARDNER

TERRACE

