


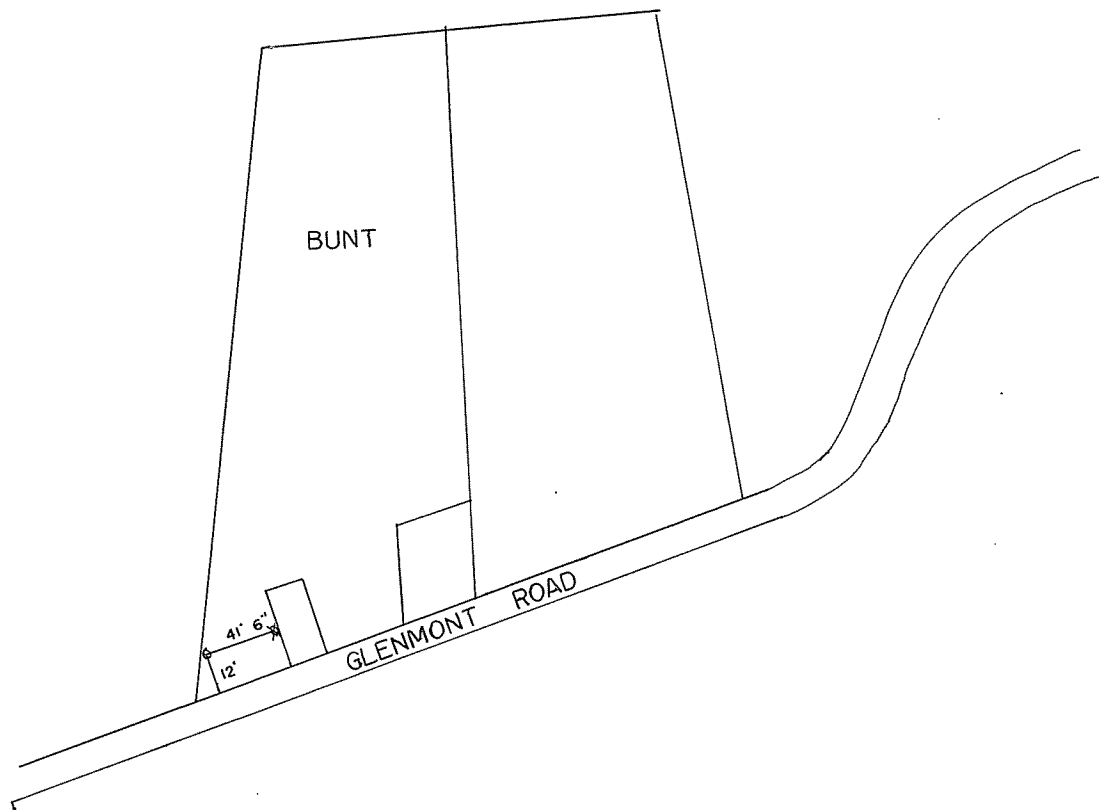

GLENMONT ROAD