


- LEGEND**
- CATCH BASIN
 - MANHOLE
 - ⊙ HYDRANT
 - ⊕ GATE VALVE
 - ⊥ TEE
 - ▲ THRUST BLOCK
 - W— WATER MAIN

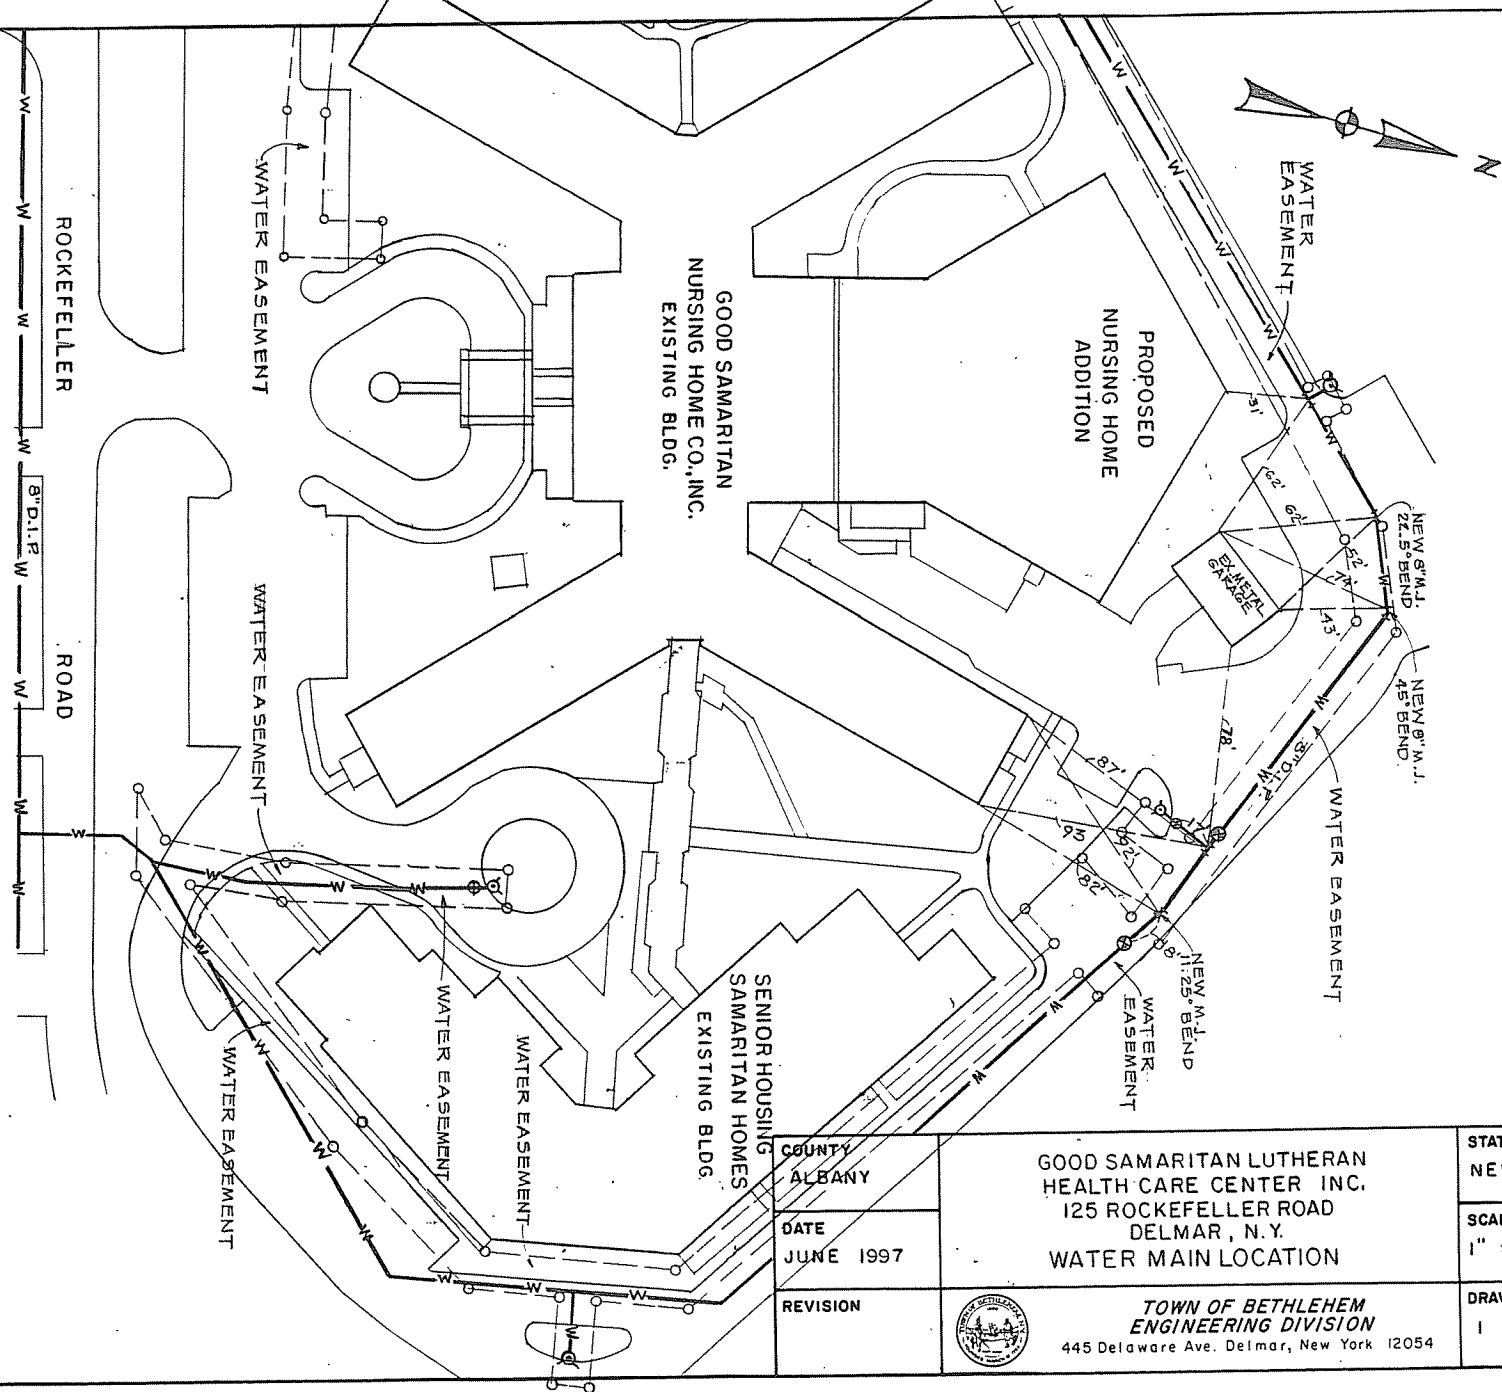

COUNTY
ALBANY

DATE
JUNE 1997

REVISION

GOOD SAMARITAN LUTHERAN
HEALTH CARE CENTER INC.
125 ROCKEFELLER ROAD
DELMAR, N.Y.
WATER MAIN LOCATION



TOWN OF BETHLEHEM
ENGINEERING DIVISION
445 Delaware Ave. Delmar, New York 12054

STATE
NEW YORK

SCALE
1" = 50'

DRAWING NO.
1 OF 2