


LEGEND

- CATCH BASIN
- MANHOLE
- ⊙ HYDRANT
- ⊕ GATE VALVE
- ⊥ TEE
- ▲ THRUST BLOCK
- W — WATER MAIN

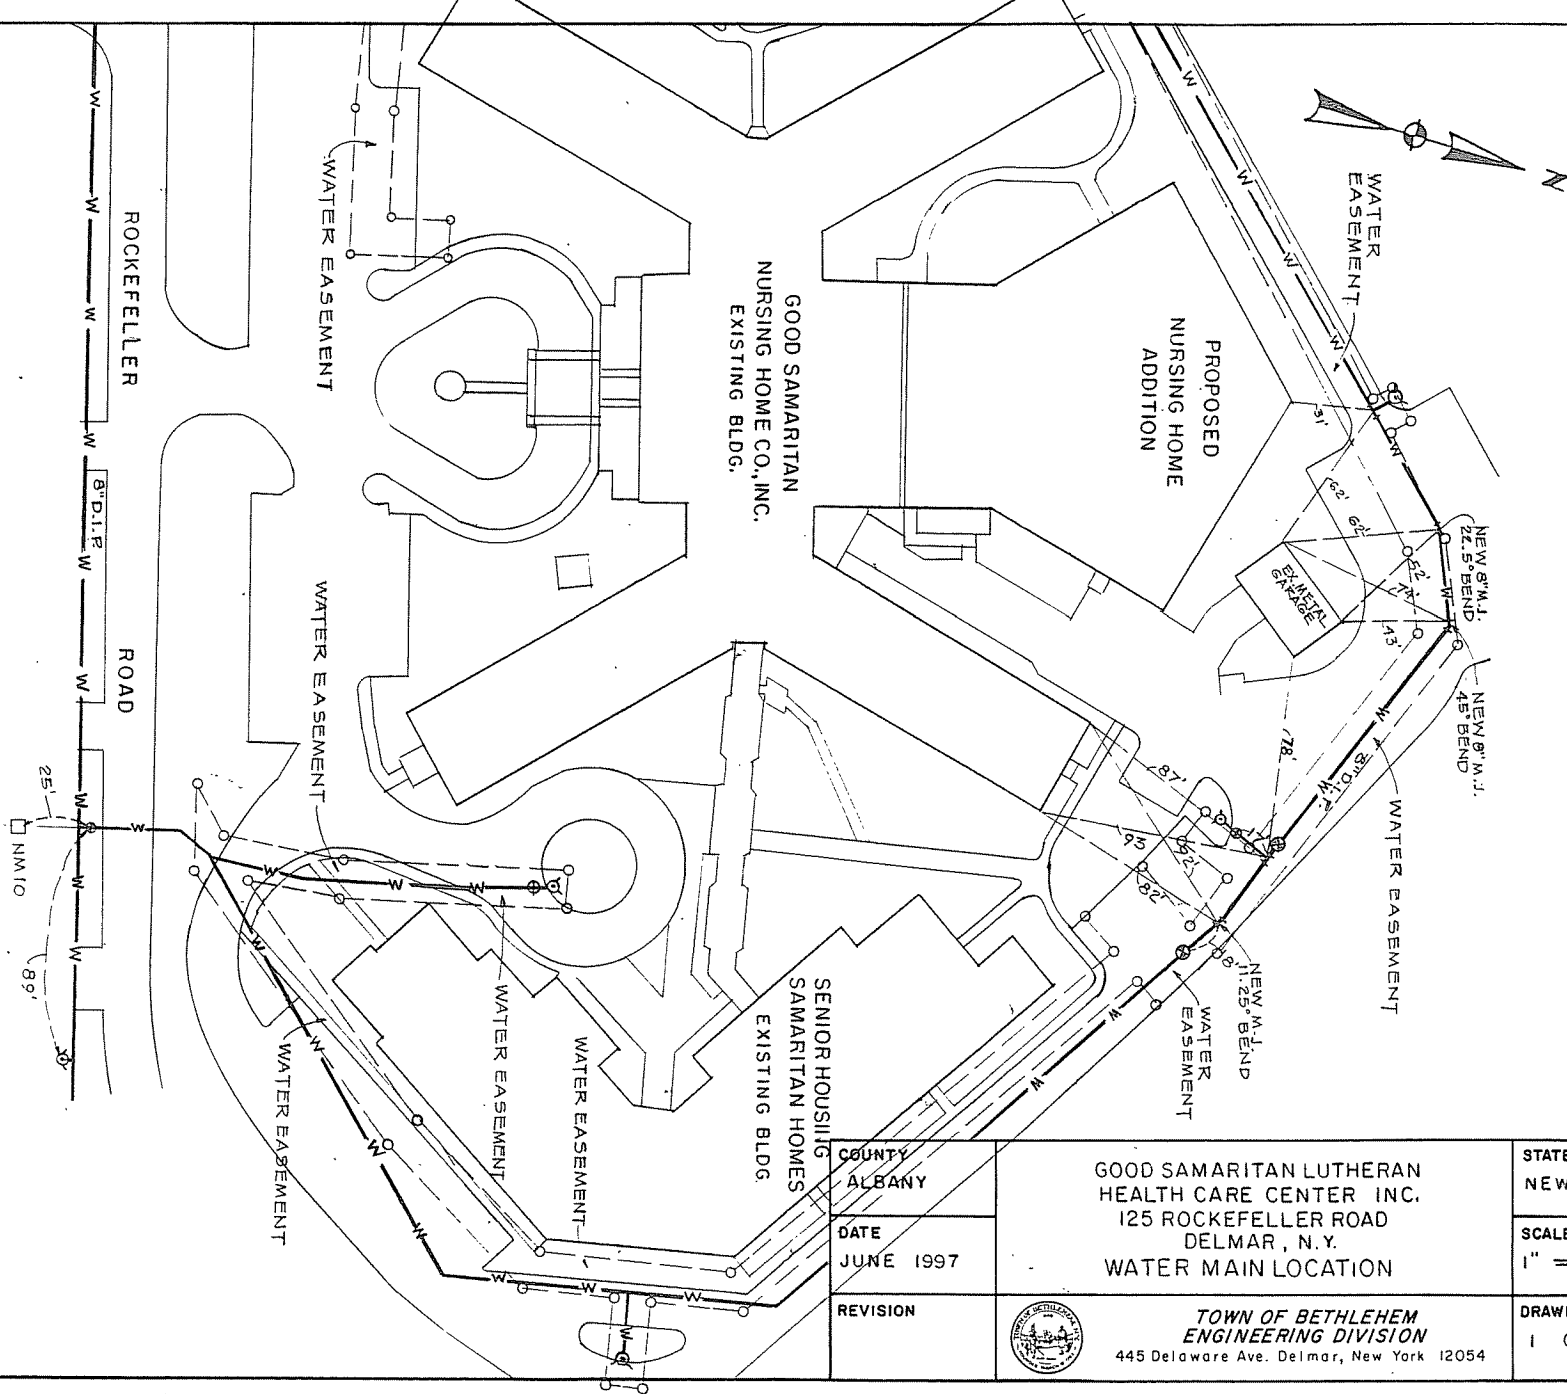

COUNTY ALBANY	GOOD SAMARITAN LUTHERAN HEALTH CARE CENTER INC. 125 ROCKEFELLER ROAD DELMAR, N.Y. WATER MAIN LOCATION	STATE NEW YORK
DATE JUNE 1997		SCALE 1" = 50'
REVISION	 TOWN OF BETHLEHEM ENGINEERING DIVISION 445 Delaware Ave. Delmar, New York 12054	DRAWING NO. 1 OF 2