


LEGEND

- CATCH BASIN
- MANHOLE
- ⊙ HYDRANT
- ⊕ GATE VALVE
- ⊥ TEE
- ▲ THRUST BLOCK
- W— WATER MAIN

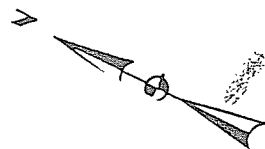

WATER EASEMENT

NEW M.D.
45° BEND

WATER EASEMENT

NEW M.D.
11.25° BEND

EX. CHAPEL BLDG.

WATER EASEMENT

PROPOSED ADULT HOME

EXISTING WATER MAIN

NEW WATER VALVE

WATER EASEMENT

POST INDICATOR VALVE

NEW WATER VALVE

WATER EASEMENT

ROAD

ROCKEFELLER

8" D.I.P. W 30.6'

8" D.I.P. W 29.7'

COUNTY ALBANY	
DATE JUNE 1997	
REVISION	



GOOD SAMARITAN LUTHERAN
HEALTH CARE CENTER INC.
125 ROCKEFELLER ROAD
DELMAR, N. Y.
WATER MAIN LOCATION

TOWN OF BETHLEHEM
ENGINEERING DIVISION
445 Delaware Ave. Delmar, New York 12054

STATE NEW YORK
SCALE 1" = 50'
DRAWING NO. 2 OF 2