


- LEGEND
- CATCH BASIN
  - MANHOLE
  - ⊙ HYDRANT
  - ⊕ GATE VALVE
  - ⊕ TEE
  - ▼ THRUST BLOCK
  - W — WATER MAIN

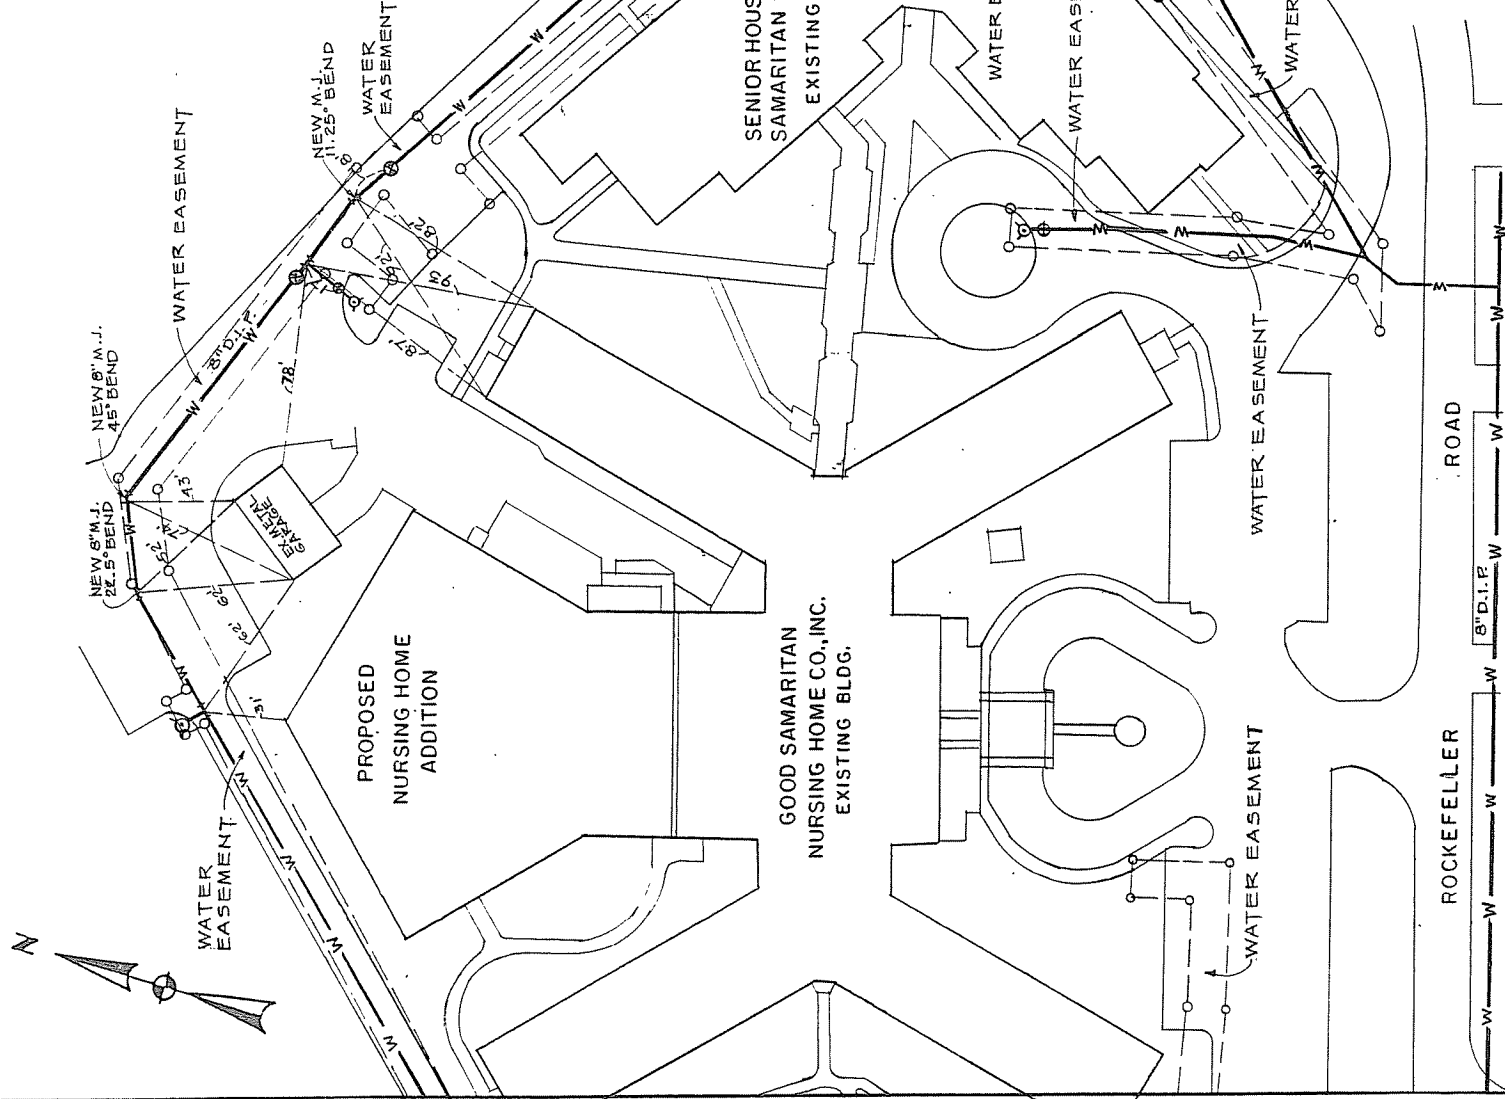

ROCKEFELLER

ROAD

SENIOR HOUSING  
SAMARITAN HOMES  
EXISTING BLDG.

GOOD SAMARITAN  
NURSING HOME CO., INC.  
EXISTING BLDG.

PROPOSED  
NURSING HOME  
ADDITION

GOOD SAMARITAN LUTHERAN  
HEALTH CARE CENTER INC.  
125 ROCKEFELLER ROAD  
DELMAR, N.Y.

COUNTY  
ALBANY

DATE  
JUNE 1997

REVISION



445 Delaware Ave. Delmar, New York 12054

TOWN OF BETHLEHEM  
ENGINEERING DIVISION

DRAWING NO.  
1 OF 2

SCALE  
1" = 50'

STATE  
NEW YORK